

Walthall  
B2030  
8-29-79

MISSISSIPPI  
 BOARD OF WATER COMMISSIONERS  
 416 North State Street  
 Jackson, Mississippi 39201

WATER WELL DRILLERS LOG

8-29 1979 Walthall Walthall  
 date well completed firm name county well located

LANDOWNER:  
Zebadiah Bristle  
RR. 1  
 (mailing address)

description of formations encountered	from	to
<u>Red Clay</u>	<u>0</u>	<u>20</u>
<u>Red Sand</u>	<u>20</u>	<u>105</u>
<u>Coarse sand &amp; gravel</u>	<u>105</u>	<u>116</u>

WELL LOCATION:  
 sec. 19 T. 4 N R. 11 E  
           S          W  
9 miles N of Lytle  
 (distance) (direction) (nearest town)

WELL PURPOSE: Home  
 (home, irrigation, municipal, industrial)

- WELL COMPLETION DATA:
- (1) diameter (inches) 4
  - (2) total depth (feet) 116
  - (3) static water level (feet) 80 above below top of ground.
  - (4) casing PVC, 108,  
 (material) (depth)  
4 if telescope see back.  
 (size)
  - (5) screen 8, 108  
 (length) (depth to top)  
4, PVC  
 (size) (material)
  - (6) pump 1/2, 10  
 (HP) (yield gpm)  
Ele  
 (type power)
  - (7) electric log no  
 (yes or no)  
 (organization running log)
  - (8) how well bottom plugged Sand Shok

DRILLERS REMARKS:


Miss. Board of Water Comm.

SEP 12 1979

RECEIVED

If well telescopes please sketch and show depths.

GROUND LEVEL

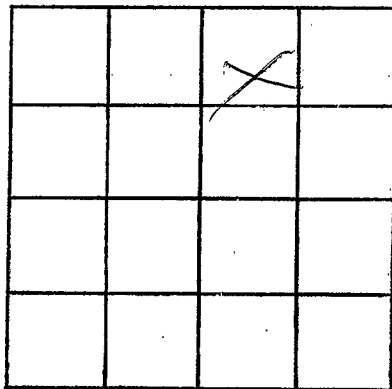

SECTION 19

Please indicate well location X.

ADDITIONAL INFORMATION

Lined area for additional information.

If more than one screen, show locations of each on sketch.