

Walthall  
B  
2031  
9-13-79

MISSISSIPPI  
 BOARD OF WATER COMMISSIONERS  
 416 North State Street  
 Jackson, Mississippi 39201

WATER WELL DRILLERS LOG

9-13 19 79 Fitzgerald well Serv Walthall  
 date well completed firm name county well located

LANDOWNER:  
Roger Payne  
R.R. Tylentown  
 (mailing address)

description of formations encountered	from	to
<u>Red clay</u>	<u>0</u>	<u>20</u>
<u>Red sand &amp; gravel</u>	<u>20</u>	<u>105</u>
<u>Coarse sand gravel</u>	<u>105</u>	<u>120</u>

WELL LOCATION:  
 sec. 29 T. 4 N. R. 11 E.  
S W  
8 miles N of Tylentown  
 (distance) (direction) (nearest town)

WELL PURPOSE: Home  
 (home, irrigation, municipal, industrial)

WELL COMPLETION DATA:  
 (1) diameter (inches) 4  
 (2) total depth (feet) 120  
 (3) static water level (feet) 60 below above top of ground.  
 (4) casing PVC, 112,  
 (material) (depth)  
4 if telescope see back.  
 (size)  
 (5) screen 8, 112  
 (length) (depth to top)  
4, PVC  
 (size) (material)  
 (6) pump 1/2, 10  
 (HP) (yield gpm)  
elec.  
 (type power)  
 (7) electric log ny  
 (yes or no)  
 (organization running log)  
 (8) how well bottom plugged Sand Plug

DRILLERS REMARKS:


DEPT. OF NATURAL RESOURCES  
 BUREAU OF LAND & WATER RESOURCES

NOV - 7 1979

RECEIVED

If well telescopes please sketch and show depths.

GROUND LEVEL

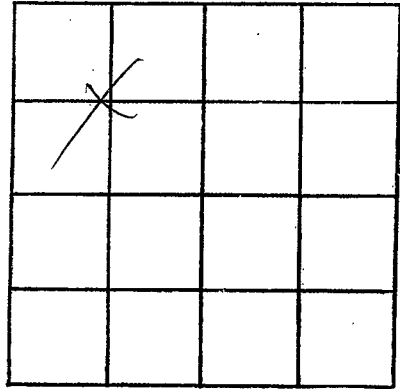

SECTION 29

Please indicate well location X.

ADDITIONAL INFORMATION

If more than one screen, show locations of each on sketch.