

Walthall
 B 2032
 5-15-80

MISSISSIPPI
 BOARD OF WATER COMMISSIONERS
 416 North State Street
 Jackson, Mississippi 39201

WATER WELL DRILLERS LOG

5-15 1980 H. J. Hallwell Inc walthall
 date well completed firm name county well located

LANDOWNER:	description of formations encountered	from	to
<u>Lester Sinn</u>			
<u>P.B. Lytle</u> (mailing address)	<u>Red clay</u> <u>Red sand</u> <u>Coarse sand & gravel</u>	<u>0</u> <u>20</u> <u>80</u>	<u>20</u> <u>80</u> <u>108</u>
<p>WELL LOCATION: <u>Sec 24 T. 4N R. 11E</u> <u>S W</u> <u>3 miles W of Darben</u> (distance) (direction) (nearest town)</p>			
<p>WELL PURPOSE: <u>Home</u> (home, irrigation, municipal, industrial)</p>			
<p>WELL COMPLETION DATA:</p> <p>(1) diameter (inches) <u>4</u></p> <p>(2) total depth (feet) <u>108</u></p> <p>(3) static water level (feet) <u>80</u> below above top of ground.</p> <p>(4) casing <u>NWC</u> <u>100</u> (material) (depth) <u>4</u> if telescope see back. (size)</p> <p>(5) screen <u>8</u> <u>100</u> (length) (depth to top) <u>4</u> <u>NWC</u> (size) (material)</p> <p>(6) pump <u>1/2</u> <u>10</u> (HP) (yield gpm) <u>elec</u> (type power)</p> <p>(7) electric log <u>no</u> (yes or no) <u>(organization running log)</u></p> <p>(8) how well bottom plugged <u>Sand fill</u></p>			
<p>DRILLERS REMARKS:</p>			


DEPT. OF NATURAL RESOURCES
 BUREAU OF LAND & WATER RESOURCES

JUN 20 1980

RECEIVED

If well telescopes please
sketch and show depths.

GROUND LEVEL

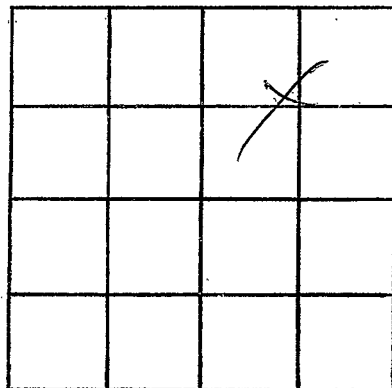

SECTION 24

Please indicate well location X.

ADDITIONAL INFORMATION

A series of horizontal lines provided for additional information.

If more than one screen,
show locations of each on sketch.