

Walthall  
 B 2033  
 8-16-80

MISSISSIPPI  
 BOARD OF WATER COMMISSIONERS  
 416 North State Street  
 Jackson, Mississippi 39201

WATER WELL DRILLERS LOG

8-16  
 date well completed

19 80

*F. S. ...*  
 firm name

Walthall  
 county well located

LANDOWNER:  
*Doug Sanders*  
*R.R. - Tolantown*  
 (mailing address)

description of formations encountered	from	to
<i>Red clay</i>	<i>17</i>	<i>20</i>
<i>Red sand</i>	<i>20</i>	<i>105</i>
<i>Caswell gravel &amp; gravel</i>	<i>105</i>	<i>116</i>

WELL LOCATION:  
 sec. *29* T. *4* N. R. *11* E  
*1* miles *W* of *Manning*  
 (distance) (direction) (nearest town)

WELL PURPOSE:  
 (home, irrigation, municipal, industrial)

- WELL COMPLETION DATA:
- (1) diameter (inches) *4*
  - (2) total depth (feet) *116*
  - (3) static water level (feet) *35* below top of ground.
  - (4) casing *PVC*, *108*,  
 (material) (depth)  
*4* if telescope see back.  
 (size)
  - (5) screen *8*, *108*  
 (length) (depth to top)  
*4*, *PVC*  
 (size) (material)
  - (6) pump *1/2*, *10*  
 (HP) (yield gpm)  
*6hp*  
 (type power)
  - (7) electric log *no*  
 (yes or no)  
 (organization running log)
  - (8) how well bottom plugged *Seal hole*


DRILLERS REMARKS:

DEPT. OF NATURAL RESOURCES  
 BUREAU OF LAND & WATER RESOURCES

SEP 3 - 1980  
 RECEIVED

If well telescopes please sketch and show depths.

GROUND LEVEL

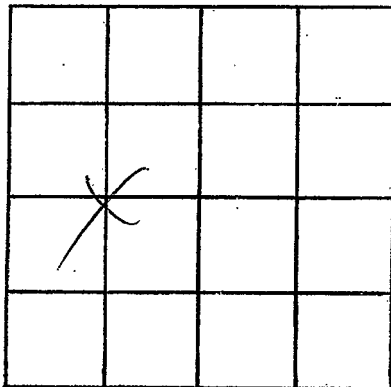

SECTION 29

Please indicate well location X.

ADDITIONAL INFORMATION

If more than one screen, show locations of each on sketch.