


WALTHALL
 B 2035
 10-7-80

Bureau of Land and Water Resources
 Southport Mall
 P.O. Box 10631
 Jackson, Mississippi 39209
 WATER WELL DRILLERS LOG


Oct 7 1980 Reems Well Inc Walthall
 date well completed firm name county well located

LANDOWNER:	description of formations encountered	from	to
Winston May Rt Jayess (mailing address)	Red sandy clay Red sand lobbly sand & gravel	0 18 70 90	18 70 90 115
WELL LOCATION: sec 8 T 4 N R 11 E in miles 2.0 of Sartanville (distance) (direction) (nearest town)			
WELL PURPOSE: home (home, irrigation, municipal, industrial)			
WELL COMPLETION DATA:			
(1) diameter (inches) 4"			
(2) total depth (feet) 115'			
(3) static water level (feet) 87' below top of ground.			
(4) casing plastic bottom (material) (depth)			
_____ If telescope see back. (size)			
(5) screen 5' 110' (length) (depth to top)			
4" plastic (size) (material)			
(6) pump 1/2 hp 10 (HP) (yield gpm)			
elect (type power)			
(7) electric log no (yes or no)			
_____ (organization running log)			
(8) how well bottom plugged each week value			
DRILLERS REMARKS:			

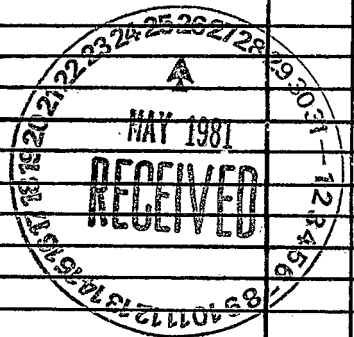

If well telescopes please sketch and show depths.

GROUND LEVEL

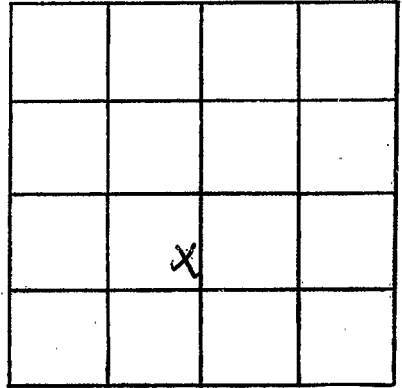

SECTION 8

Please indicate well location X.

ADDITIONAL INFORMATION

If more than one screen,
show locations of each on sketch.