


Walthall  
 B 2036  
 7-1-81

MISSISSIPPI  
 BOARD OF WATER COMMISSIONERS  
 416 North State Street  
 Jackson, Mississippi 39201

WATER WELL DRILLERS LOG


7-1 1981 F. General and S. Walthall Walthall  
 date well completed firm name county well located

LANDOWNER:	description of formations encountered	from	to
<u>Marion Goode</u>			
<u>P.R. Lyberty</u> (mailing address)	<u>Red clay</u> <u>Red sand</u> <u>Coarse sand &amp; gravel</u>	<u>0</u> <u>20</u> <u>70</u>	<u>20</u> <u>70</u> <u>96</u>
<b>WELL LOCATION:</b>			
sec. <u>34</u> T. <u>4</u> N R. <u>11</u> E S W <u>5</u> miles <u>NE</u> of <u>Selen</u> (distance) (direction) (nearest town)			
<b>WELL PURPOSE:</b> (home, irrigation, municipal, industrial)			
<b>WELL COMPLETION DATA:</b>			
(1) diameter (inches) <u>4</u>			
(2) total depth (feet) <u>96</u>			
(3) static water level (feet) <u>55</u> below top of ground.			
(4) casing <u>PVC</u> , <u>88</u> (material) (depth)			
<u>4</u> if telescope see back. (size)			
(5) screen <u>8</u> , <u>88</u> (length) (depth to top)			
<u>4</u> , <u>PVC</u> (size) (material)			
(6) pump <u>1/2</u> , <u>10</u> (HP) (yield gpm)			
<u>elc</u> (type power)			
(7) electric log <u>No</u> (yes or no)			
(organization running log)			
(8) how well bottom plugged <u>Sand &amp; Kk</u>			
<b>DRILLERS REMARKS:</b>			

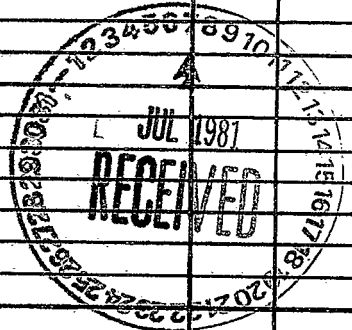

If well telescopes please sketch and show depths.

GROUND LEVEL

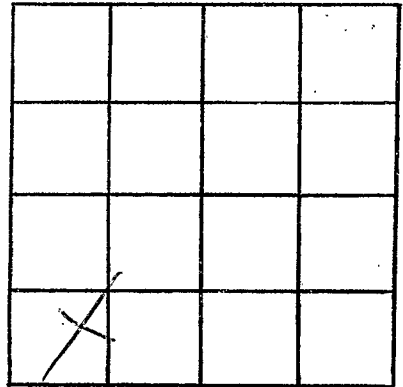

SECTION 34

Please indicate well location X.

ADDITIONAL INFORMATION

If more than one screen,  
show locations of each on sketch.