

WALTHALL

B 2037

7-31-81

MISSISSIPPI
BOARD OF WATER COMMISSIONERS
416 North State Street
Jackson, Mississippi 39201

WATER WELL DRILLERS LOG

July 31 1981 Green Water Wll Cont. Walthall
date well completed firm name county well located

LANDOWNER: Mike Sistrunk Tylertown, Ms. (mailing address)	description of fomations encountered Citronelle	from 1	to 120
WELL LOCATION: sec 8 T 4 N R 11 E 14 miles N of Tylertown (distance) (direction) (nearest town)			
WELL PURPOSE: home (home, irrigation, municipal, industrial)			
WELL COMPLETION DATA: (1) diameter (inches) 4 (2) total depth (feet) 120 (3) static water level (feet) 60 below above top of ground. (4) casing PVC 110' (material) (depth) 4" if telescope see back. (size) (5) screen 10' 110' (length) (depth to top) .010, PVC (size) (material) (6) pump did not install (HP) (yield gpm) (type power) (7) electric log no (yes or no) (organization running log)			
DRILLERS REMARKS:			


DEPT. OF NATURAL RESOURCES
BUREAU OF LAND & WATER RESOURCES

AUG 14 1981

RECEIVED

If well telescopes please sketch and show depths.

GROUND LEVEL

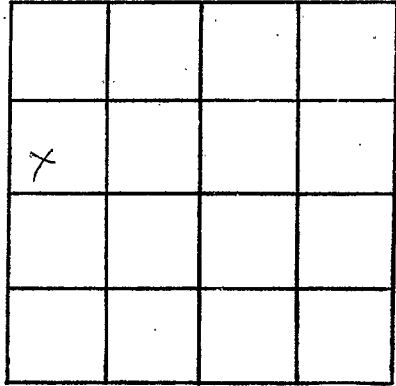

SECTION 8

Please indicate well location X.

ADDITIONAL INFORMATION

If more than one screen,
show locations of each on sketch.