

WALTHALL
B 2038
9-29-81

MISSISSIPPI
BOARD OF WATER COMMISSIONERS
416 North State Street
Jackson, Mississippi 39201

WATER WELL DRILLERS LOG

9-29 1981 Fitzgerald Well Sew Walthall
date well completed firm name county well located

LANDOWNER:	description of formations encountered	from	to
<u>Sammy Mazer</u>	<u>Red clay</u>	0	20
<u>R.R. Tykietown</u> (mailing address)	<u>Red granite</u>	20	70
WELL LOCATION: sec. <u>31</u> T. <u>4</u> N. R. <u>11</u> E S W	<u>Red sand</u>	70	140
<u>10</u> miles <u>N</u> of <u>Tykietown</u> (distance) (direction) (nearest town)	<u>Coarse sandstone</u>	140	153
WELL PURPOSE: <u>Home</u> (home, irrigation, municipal, industrial)			
WELL COMPLETION DATA:			
(1) diameter (inches) <u>4</u>			
(2) total depth (feet) <u>153</u>			
(3) static water level (feet) <u>60</u> below top of ground. above			
(4) casing <u>PVC</u> , <u>145</u> , (material) (depth)			
<u>4</u> if telescope see back. (size)			
(5) screen <u>8</u> , <u>145</u> (length) (depth to top)			
<u>4</u> , <u>PVC</u> (size) (material)			
(6) pump <u>1/2</u> <u>10</u> (HP) (yield gpm)			
<u>elec</u> (type power)			
(7) electric log <u>No</u> (yes or no)			
(organization running log)			
(8) how well bottom plugged <u>Sand blk</u>			
DRILLERS REMARKS:			


DEPT. OF NATURAL RESOURCES
BUREAU OF LAND & WATER RESOURCES

NOV 20 1981

RECEIVED

If well telescopes please sketch and show depths.

GROUND LEVEL

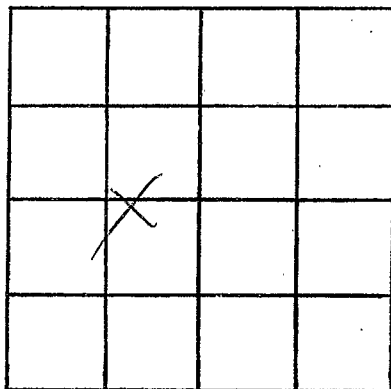

SECTION 31

Please indicate well location X.

ADDITIONAL INFORMATION

If more than one screen,
show locations of each on sketch.