

MISSISSIPPI DEPARTMENT OF NATURAL RESOURCES

Bureau of Land and Water Resources

Southport Mall

P.O. Box 10631

Jackson, Mississippi 39209

WATER WELL DRILLERS LOG

Walthall
B2055

Aug 13 1981 Reene well in Walthall
 date well completed firm name county well located

LANDOWNER:	description of formations encountered	from	to
<p><u>Rickey Terry</u> <u>PO Jayess</u> (mailing address)</p>	<p><u>Red Clay</u> <u>Red sand</u> <u>Red Chalk</u></p>	<p><u>0</u></p>	<p><u>22</u> <u>70</u> <u>85</u></p>
<p>WELL LOCATION: sec. <u>24</u> T. <u>4</u> N. R. <u>11</u> E. <u>2</u> miles <u>north</u> of <u>Darbin</u> (distance) (direction) (nearest town)</p>	<p><u>Sand gravel & clay</u> <u>White Chalk</u> <u>Sand + pebbles</u></p>	<p><u>85</u> <u>130</u> <u>142</u> <u>185</u></p>	<p><u>130</u> <u>142</u> <u>185</u></p>
<p>WELL PURPOSE: <u>Home</u> (home, irrigation, municipal, industrial)</p>			
<p>WELL COMPLETION DATA:</p>			
<p>(1) diameter (inches) <u>4"</u></p>			
<p>(2) total depth (feet) <u>185'</u></p>			
<p>(3) static water level (feet) <u>116</u> below above top of ground.</p>			
<p>(4) casing <u>plastic bottom</u> (material) (depth)</p>			
<p><u>-</u> If telescope see back. (size)</p>			
<p>(5) screen <u>10'</u> <u>175'</u> (length) (depth to top)</p>			
<p><u>1/2"</u> <u>plastic</u> (size) (material)</p>			
<p>(6) pump <u>3/4</u> <u>12</u> (HP) (yield gpm)</p>			
<p><u>split</u> (type power)</p>			
<p>(7) electric log <u>no</u> (yes or no)</p>			
<p><u>-</u> (organization running log)</p>			
<p>(8) how well bottom plugged <u>back wash valve</u></p>			
<p>DRILLERS REMARKS: <u>-</u></p>			


DEPT. OF NATURAL RESOURCES
 BUREAU OF LAND & WATER RESOURCES

MAR 15 1982

RECEIVED

If well telescopes please sketch and show depths.

GROUND LEVEL

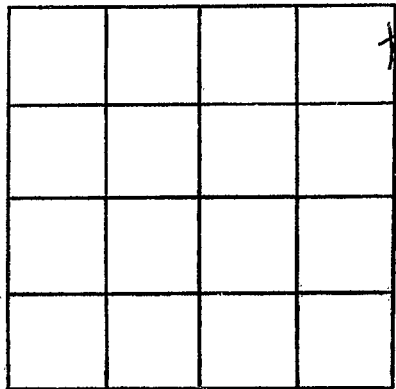

SECTION 24

Please indicate well location X.

ADDITIONAL INFORMATION

If more than one screen, ³³ show locations of each on sketch.