

MISSISSIPPI DEPARTMENT OF NATURAL RESOURCES

Bureau of Land and Water Resources

Southport Mall

P.O. Box 10631

Jackson, Mississippi 39209

WATER WELL DRILLERS LOG

Walthall
B 2040

1-3
date well completed

1984

Signal Well Sew
firm name


Walthall
county well located

LANDOWNER:	description of formations encountered	from	to
<u>Louisa Carr</u>			
<u>RR. Tylertown, Ms.</u> (mailing address)	<u>Red clay</u>	<u>0</u>	<u>20</u>
	<u>Red sand</u>	<u>20</u>	<u>90</u>
	<u>Coarse sand & gravel</u>	<u>90</u>	<u>108</u>
WELL LOCATION:			
sec. <u>26</u> T. <u>4</u> N. R. <u>11</u> E S W			
<u>4</u> miles <u>E</u> of <u>MANINGSS</u> (distance) (direction) (nearest town)			
WELL PURPOSE: <u>Home</u> (home, irrigation, municipal, industrial)			
WELL COMPLETION DATA:			
(1) diameter (inches) <u>4</u>			
(2) total depth (feet) <u>108</u>			
(3) static water level (feet) <u>85</u> below top of ground.			
(4) casing <u>PVC</u> , <u>100</u> , (material) (depth) <u>4</u> if telescope see back. (size)			
(5) screen <u>8</u> , <u>100</u> (length) (depth to top) <u>4</u> , <u>PVC</u> (size) (material)			
(6) pump <u>1/2</u> , <u>10</u> (HP) (yield gpm) <u>Elc</u> (type power)			
(7) electric log <u>no</u> (yes or no)			
(organization running log)			
(8) how well bottom plugged <u>Sand Sh.</u>			
DRILLERS REMARKS:			

DEPT. OF NATURAL RESOURCES
BUREAU OF LAND & WATER RESOURCES
RECEIVED
MAR - 6 1984

If well telescopes please sketch and show depths.

GROUND LEVEL

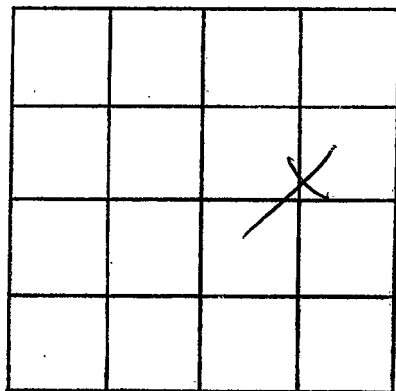

SECTION 26

Please indicate well location X.

ADDITIONAL INFORMATION

If more than one screen,
show locations of each on sketch.