

WATHALL
B 2043

MISSISSIPPI DEPARTMENT OF NATURAL RESOURCES
Bureau of Land and Water Resources
Southport Mall
P.O. Box 10631
Jackson, Mississippi 39209
WATER WELL DRILLERS LOG

COPY

7-17 1986
date well completed

Hollinger
firm name

Wathall
county well located

LANDOWNER: Gentrude Thompson

Description of formations encountered

from to

Tyler town, ms

0

(mailing address)

WELL LOCATION:

sec 25 T 4 N R 11 E
S W
18 miles W of Foxworth
(distance) (direction) (nearest town)

WELL PURPOSE: Pond
(home, irrigation, municipal, industrial)

WELL COMPLETION DATA:

- (1) diameter (inches) 4"
- (2) total depth (feet) 190
- (3) static water level (feet) 570 (below above top of ground)
- (4) casing casing (material) (depth)
if telescope see back.
(size)
- (5) screen 20 170 (length) (depth to top)
4 pvc (size) (material)
- (6) pump 5HP 100 gpm (HP) (yield gpm)
elect (type power)
- (7) electric log (yes or no)

RECEIVED

DEC 11 1986

Department of Natural Resources
Bureau of Land & Water Resources


(organization running log)

(8) how well bottom plugged Sand
Shale

DRILLERS REMARKS: Very
Good well

If well telescopes please sketch and show depths.

GROUND LEVEL

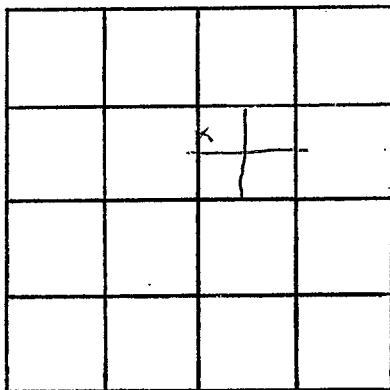

SECTION 25

Please indicate well location X.

ADDITIONAL INFORMATION

If more than one screen,
show locations of each on sketch.