


If well telescopes please sketch and show depths.

GROUND LEVEL

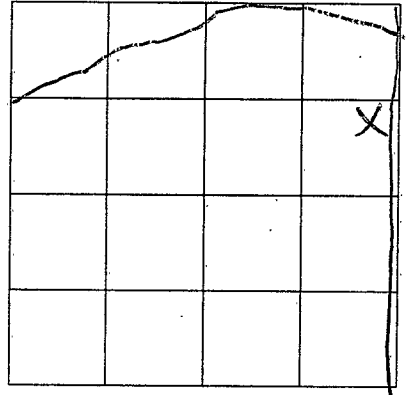

SECTION 13

Please indicate well location X.

ADDITIONAL INFORMATION

191319141915

1916 1917 1918

1919 1920 1921 1922

If more than one screen,
show location of each on sketch.