

WALTHALL  
C  
3-68

A

MISSISSIPPI  
BOARD OF WATER COMMISSIONERS  
416 North State Street  
Jackson, Mississippi 39201

WATER WELL DRILLERS LOG

3-18 1968 Fredgerald Water Well Walthall  
date well completed firm name county well located

LANDOWNER: Nazarie Brumfield  
Rt 3 Tybertown  
(mailing address)


WELL LOCATION:  
sec. 1 T. 4 N. 9 E  
S. W.  
15 miles SE of Malcomb  
(distance) (direction) (nearest town)

WELL PURPOSE: home  
(home, irrigation, municipal, industrial)

- WELL COMPLETION DATA:
- (1) diameter (inches) 4
  - (2) total depth (feet) 180
  - (3) static water level (feet) 115 below top of ground.
  - (4) casing plastic 174  
(material) (depth)  
4 if telescope see back.  
(size)
  - (5) screen 6' 174  
(length) (depth to top)  
4 Sch 40  
(size) (material)
  - (6) pump 1/2 10  
(HP) (yield gpm)  
Elec  
(type power)
  - (7) electric log no  
(yes or no)
  - (8) how well bottom plugged Wood peg

Description of formations encountered	from	to
Top soil / clay	0	25
Red sand	25	58
gravel	58	75
bank	75	102
gravel	102	120
loosey sand	120	165
Coarse sand / gravel	165	180


CODED

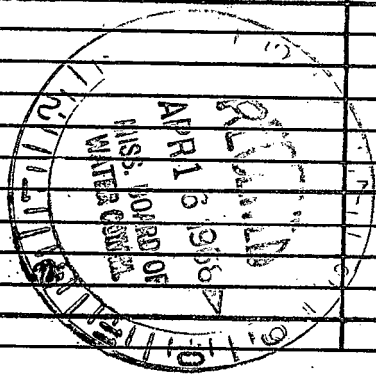

DRILLERS REMARKS:

If well telescopes please sketch and show depths.

GROUND-LEVEL

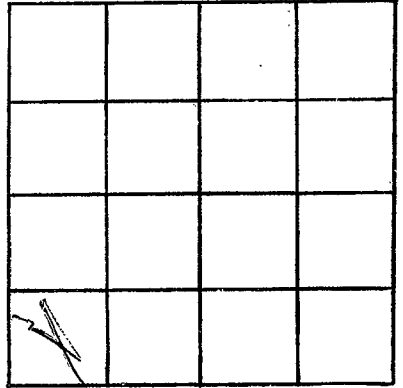

SECTION 1

Please indicate well location X.

ADDITIONAL INFORMATION

If more than one screen,  
show locations of each on sketch.