

CODED

MISSISSIPPI BOARD OF WATER COMMISSIONERS
416 North State Street
Jackson, Mississippi 39201

C
WALTHALL
8-8-73

WATER WELL DRILLERS LOG

8-8 1973 Hygeal Well Ltd Walthall
date well completed firm name county well located

LANDOWNER:
James Lee
R.R. Lybster
(mailing address)

description of formations encountered	from	to
<u>Red clay</u>	<u>0</u>	<u>20</u>
<u>Red sand</u>	<u>20</u>	<u>120</u>
<u>Coarse sand's gravel</u>	<u>120</u>	<u>134</u>

WELL LOCATION:
sec. 6 T. 3 N. R. 10 E.
9 miles W of Lybster
(distance) (direction) (nearest town)

WELL PURPOSE:
flow
(home, irrigation, municipal, industrial)

- WELL COMPLETION DATA:
- (1) diameter (inches) 4
 - (2) total depth (feet) 134
 - (3) static water level (feet) 105 ^{below} / above top of ground.
 - (4) casing plastic 126
(material) (depth)
4 if telescope see back.
(size)
 - (5) screen 8 126
(length) (depth to top)
4 plastic
(size) (material)
 - (6) pump 1/2 10
(HP) (yield gpm)
elec
(type power)
 - (7) electric log no
(yes or no)
 - (organization running log)
 - (8) how well bottom plugged completely


AUG 15 1973

DRILLERS REMARKS:

MISS. BD. OF WATER COM.

If well telescopes please sketch and show depths.

GROUND LEVEL

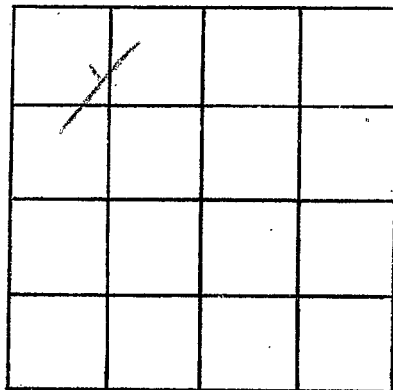

SECTION 6

Please indicate well location X.

ADDITIONAL INFORMATION

If more than one screen,
show locations of each on sketch.