

WALTHALL
 3-68
 CODED

MISSISSIPPI
 BOARD OF WATER COMMISSIONERS
 416 North State Street
 Jackson, Mississippi 39201

WATER WELL DRILLERS LOG

3-31-1968 date well completed
 68 Fitzgerald Well Walthall firm name
 Walthall county well located

LANDOWNER: James Thornton
 Rt 3 Light town
 (mailing address)


Description of formations encountered	from	to
top soil & clay	0	12
Red sand	12	55
gravel	55	78
clay & chert	78	86
hard & gravel	86	190
loam sand	190	195
fine gravel	195	200

WELL LOCATION:
 sec. 1 T. 4 N. R. 9 E
 14 miles SE of McComb
 (distance) (direction) (nearest town)

WELL PURPOSE: home
 (home, irrigation, municipal, industrial)


- WELL COMPLETION DATA:
- (1) diameter (inches) 4
 - (2) total depth (feet) 206
 - (3) static water level (feet) 110 below above top of ground.
 - (4) casing plastic 200' (material) (depth)
 4" if telescope see back. (size)
 - (5) screen 6' 200' (length) (depth to top)
 4" Sch 40 (size) (material)
 - (6) pump 1/2 HP 10 (HP) (yield gpm)
 Elec (type power)
 - (7) electric log No (yes or no)
 - (8) how well bottom plugged Wood plug

DRILLERS REMARKS:

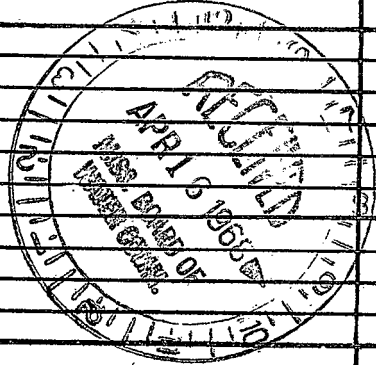

If well telescopes please sketch and show depths.

GROUND LEVEL

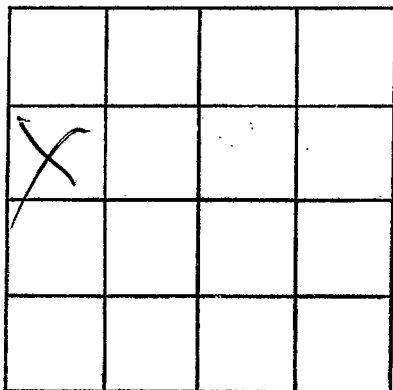

SECTION 1

Please indicate well location X.

ADDITIONAL INFORMATION

If more than one screen,
show locations of each on sketch.