

C 9

C 300

4-13-61

CODED

WATER WELL DRILLERS LOG

Date: 4-13, 1961, Driller: Chester Reeves County, Walthall (Name)

(1) Owner of Land: J. W. Powe
 (Name)
 RFD 5, Tyler town
 (Address)

(2) Location: 1/4, 1/4, Sec 20 T. 380
 10 miles N.W. of Tyler town
 (distance) (direction) (Nearest Town)

(3) Topography: Hilly
 (Hilly) (Flat) (Level)

(4) Purpose of Well: Domestic
 (Domestic Irrigation
 Municipal, Industrial, Other)

Description & Color of Materials Sand, Clay, Red Clay, Shell, etc.	Thick- ness Feet	Depth Feet
Red Clay	22	22
Red Sand	38	60
Exp. Sand & gravel	14	74
Red. Sandy fine	46	120
Sand	55	175
white Chalk		
Gravel Sand	7	182

Information upon completion of well:

(1) Diameter 2" inches.

(2) Total Depth 182 feet.


(3) Water Level 110 feet below top of ground.

(4) Cased to 176, Size 2"

(5) Screen: Size 1 1/4, Length 6'

(6) Were any formations sealed against pollution?
 yes, no.

CODED

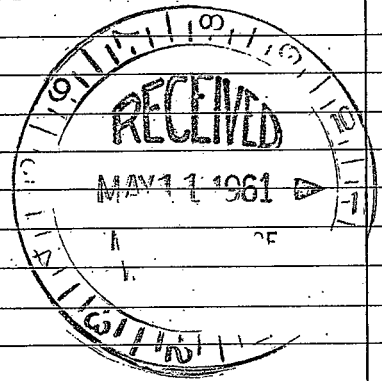

If YES depth of formation _____

Why _____

Drillers Remarks: Had to seal well at Dry

REEVES WELL AND PUMP CO.
 Phone 1250
 McCOMB, MISSISSIPPI

(Use Back Side)

Well No.

