

Walthall
C 10

MISSISSIPPI BOARD OF WATER COMMISSIONERS

7-29-66
CODED

WATER WELL DRILLERS LOG

Date: 7/29, 1966, Driller: T. B. Andrews County Walthall
(Name)

(1) Owner of Land: Jimmy Johnston
(Name)

Rt. 4 Tyler town, Miss.
(Address)

(2) Location: NW 1/4, NW 1/4, Sec. 11 T3R10,
8 1/2 miles N.W. of Tyler town,
(distance) (direction) (Nearest Town)

(3) Topography: Hilly
(Hilly) (Flat) (Level)

(4) Purpose of Well: Domestic
(Domestic Irrigation
Municipal, Industrial, Other)

Description & Color of Materials Sand, Clay, Red Clay, Shell, etc.	Thick- ness Feet	Depth Feet
<u>Red Clay</u>	<u>40'</u>	<u>40'</u>
<u>Sand</u>	<u>5'</u>	<u>45'</u>
<u>Chalk</u>	<u>35'</u>	<u>80'</u>
<u>Sand / gravel</u>	<u>5'</u>	<u>85'</u>
<u>Chalk</u>	<u>20'</u>	<u>105'</u>
<u>Sand</u>	<u>15'</u>	<u>120'</u>
<u>Sand / gravel</u>	<u>10'</u>	<u>130'</u>

Information upon completion of well:

(1) Diameter 4 inches.

(2) Total Depth 130 feet.

(3) Water Level 80 feet below top of ground.

(4) Cased to 130', Size 4"

(5) Screen: Size 4", Length 6'


(6) Were any formations sealed against pollution?
yes, no.

If YES depth of formation _____

Why _____

Drillers Remarks: _____

Plastic well

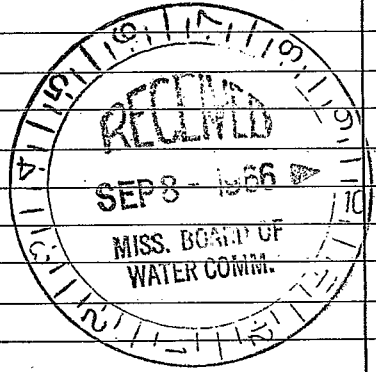

(Use Back Side)

26

Well No.

