

Walthall

C 14

MISSISSIPPI BOARD OF WATER COMMISSIONERS

9-2-66

CODED

WATER WELL DRILLERS LOG

Date: 9/2, 1966, Driller: T. B. Anderson County Walthall (Name)

(1) Owner of Land: Percy Carr
 (Name)
 Rt. 1 Tyler town, Miss
 (Address)

(2) Location: SE 1/4, NW 1/4, Sec. 1 T3 R10 E
 10 1/2 miles NW, of Tyler town
 (distance) (direction) (Nearest Town)

(3) Topography: Hilly
 (Hilly) (Flat) (Level)

(4) Purpose of Well: Domestic
 (Domestic Irrigation
 Municipal, Industrial, Other)

Description & Color of Materials Sand, Clay, Red Clay, Shell, etc.	Thick- ness Feet	Depth Feet
Red clay	20'	20'
Red Clay	20'	40'
Chalk	25'	65'
Sand / gravel	5'	70'
Chalk	5'	75'
Sand / gravel	11'	86'

Information upon completion of well:

(1) Diameter 4 inches.

(2) Total Depth 86 feet.

(3) Water Level 65 feet below top of ground.

(4) Cased to 86', Size 4"


(5) Screen: Size 4", Length 6'

(6) Were any formations sealed against pollution?
 yes, no.

If YES depth of formation _____

Why _____

Drillers Remarks:
 Plastic well

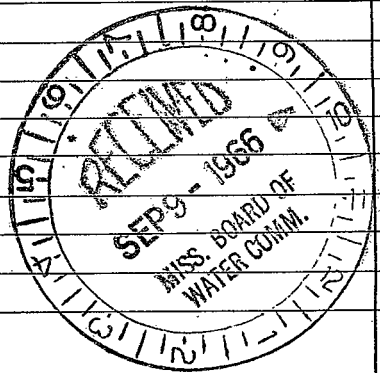

(Use Back Side)

37

Well No.

