

**MISSISSIPPI
BOARD OF WATER COMMISSIONERS**
416 North State Street
Jackson, Mississippi 39201

WATER WELL DRILLERS LOG

Walthall
C 15
4-67 CODED

4/18 1967 Andy's Drilling Co. Walthall
date well completed firm name county well located

LANDOWNER: Willford Jackson
Et. 3 Tubertown, Miss

(mailing address)

WELL LOCATION:
sec. 6 T. 3 N R. 10 E
9 miles N.W. of Tubertown
(distance) (direction) (nearest town)

WELL PURPOSE: Home
(home, irrigation, municipal, industrial)

WELL COMPLETION DATA:

(1) diameter (inches) 4"

(2) total depth (feet) 130'

(3) static water level (feet) 80' below
top of ground.

(4) casing P.V.C. 124'
(material) (depth)
4" if telescope see back.
(size)

(5) screen 6' +30' 124'
(length) (depth to top)
4" P.V.C.
(size) (material)

(6) pump 3/4 12
(HP) (yield gpm)

P.E.A. 220
(type power)

(7) electric log no
(yes or no)

description of formations encountered	from	to
<u>Red Clay</u>	<u>0'</u>	<u>30'</u>
<u>Sand/gravel</u>	<u>30'</u>	<u>60'</u>
<u>Chalk</u>	<u>60'</u>	<u>80'</u>
<u>Sand</u>	<u>80'</u>	<u>90'</u>
<u>Grey Clay Blue Shale</u>	<u>90'</u>	<u>115'</u>
<u>Sand - ped gravel</u>	<u>115'</u>	<u>130'</u>


CODED

(8) how well bottom plugged Back
Wash valve

DRILLERS REMARKS:

If well telescopes please sketch and show depths.

GROUND LEVEL

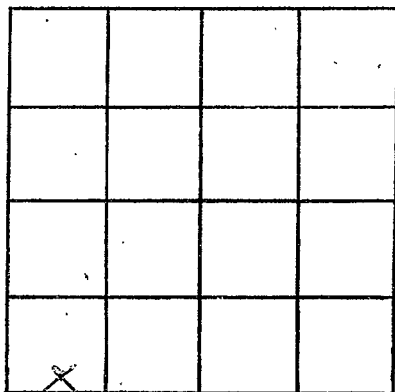

SECTION 6

Please indicate well location X.

ADDITIONAL INFORMATION

If more than one screen, show locations of each on sketch.