

Walthall
 C 17
 5-67

MISSISSIPPI
 BOARD OF WATER COMMISSIONERS
 416 North State Street
 Jackson, Mississippi 39201

WATER WELL DRILLERS LOG

May 28 1967 date well completed
 67 Fitzgerald Water Well firm name
 Walthall county well located

LANDOWNER: J.C. Peters
 Rt 3 Tyler town
 (mailing address)


description of formations encountered	from	to
Top soil & clay	0	12
Red sand	12	60
Heavy gravel	60	82
Red Chalk	82	90
gravel sand	90	140

WELL LOCATION:
 sec 31 T 10 N R 2 E
 S W
 10 miles W of Tyler town
 (distance) (direction) (nearest town)

WELL PURPOSE: home
 (home, irrigation, municipal, industrial)

- WELL COMPLETION DATA:
- (1) diameter (inches) 4
 - (2) total depth (feet) 135
 - (3) static water level (feet) 118 below top of ground.
 - (4) casing plastic (material) 120 (depth)
 - 4 (size) if telescope see back.
 - (5) screen 71 (length) 128 (depth to top)
 - 4 (size) plastic (material)
 - (6) pump Sub 1/4 (HP) 10 (yield gpm)
 - Klec (type power)
 - (7) electric log No (yes or no)
 - (organization running log)
 - (8) how well bottom plugged Wood peg


CODED

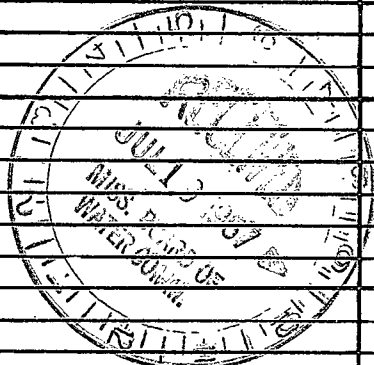

DRILLERS REMARKS:

If well telescopes please sketch and show depths.

GROUND LEVEL

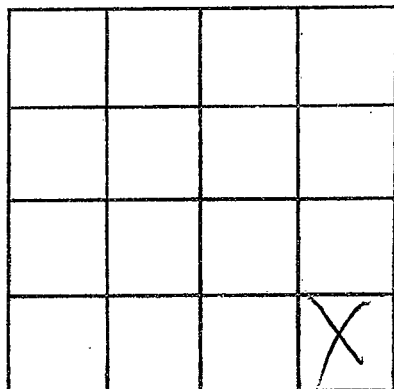

SECTION 31

Please indicate well location X.

ADDITIONAL INFORMATION

If more than one screen, show locations of each on sketch.