

Waithall
 C 18
 7-67

CODED

MISSISSIPPI
 BOARD OF WATER COMMISSIONERS
 416 North State Street
 Jackson, Mississippi 39201

WATER WELL DRILLERS LOG

7/8/1967 date well completed
 Anderson Drilling Co. firm name
 Waithall county well located

LANDOWNER: David Boyd
 Rt. 3
 Tylertown, Miss.
 (mailing address)

description of formations encountered	from	to
Clay	0'	20'
Sand	20'	60'
Chalk	60'	80'
Coarse sand / fine gravel	80'	110'


WELL LOCATION:
 sec 3 T 3 N R 10 E
 4 miles S of Eland
 (distance) (direction) (nearest town)

WELL PURPOSE: Home
 (home, irrigation, municipal, industrial)

WELL COMPLETION DATA:

- (1) diameter (inches) 4"
- (2) total depth (feet) 110'
- (3) static water level (feet) 60' below top of ground.
- (4) casing P.V.C. 104' (material) (depth)
 4" (size) if telescope see back.
- (5) screen 6' 110' (length) (depth to top)
 4" P.V.C. (size) (material)
- (6) pump 1 Jet 12 (HP) (yield gpm)
 220 (type power)
- (7) electric log No (yes or no)
- (organization running log)
- (8) how well bottom plugged Back wash 12/67


CODED

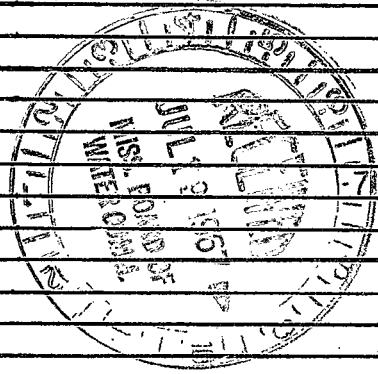

DRILLERS REMARKS:

If well telescopes please sketch and show depths.

GROUND LEVEL

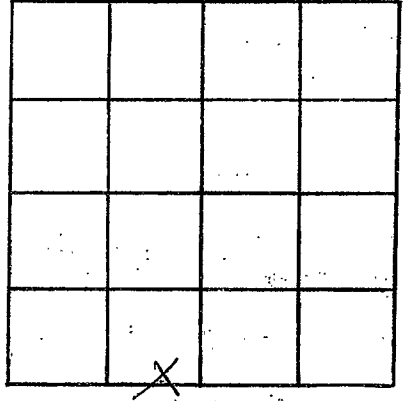

SECTION 3

Please indicate well location X.

ADDITIONAL INFORMATION

If more than one screen, show locations of each on sketch.