

Walthall
 C 19 CODED
 8-67

MISSISSIPPI
 BOARD OF WATER COMMISSIONERS
 416 North State Street
 Jackson, Mississippi 39201

WATER WELL DRILLERS LOG

8/22/67 date well completed
 Andy's Drilling firm name
 Walthall county well located

LANDOWNER: Jessie Smith
 Tulestawn, Miss
 Rt. 5 39667
 (mailing address)

description of formations encountered	from	to
Red Clay	0'	20'
Chalk	20'	60'
Gravel	60'	80'
Coarse Sand / Gravel	80'	120'

WELL LOCATION:
 sec. 11 T. 3 N R. 10 E
 8 miles N.W. of Tulestawn
 (distance) (direction) (nearest town)

WELL PURPOSE: Home
 (home, irrigation, municipal, industrial)

- WELL COMPLETION DATA:
- (1) diameter (inches) 4"
 - (2) total depth (feet) 120'
 - (3) static water level (feet) 80' below top of ground.
 - (4) casing P.V.C. 1 1/4"
 (material) (depth)
4" if telescope see back.
 (size)
 - (5) screen 6' 120'
 (length) (depth to top)
4" P.V.C.
 (size) (material)
 - (6) pump 3/4 10
 (HP) (yield gpm)
 R.E.A. 220
 (type power)
 - (7) electric log No
 (yes or no)


(8) how well bottom plugged: Back Wash Valve

DRILLERS REMARKS:



If well telescopes please sketch and show depths.

GROUND LEVEL

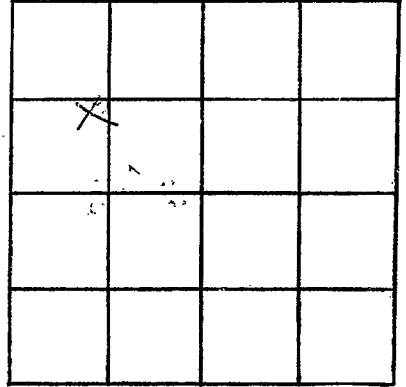

SECTION 11

Please indicate well location X.

ADDITIONAL INFORMATION

If more than one screen,
show locations of each on sketch.