

Waltheil
 C20
 8-67
 CODED

MISSISSIPPI
 BOARD OF WATER COMMISSIONERS
 416 North State Street
 Jackson, Mississippi 39201

WATER WELL DRILLERS LOG

8-2 1967 Fitzgerald W/ W. Sen Waltheil
 date well completed firm name county well located

LANDOWNER: Roy Harvey
R5 Tylertown, Miss
 (mailing address)

description of formations encountered	from	to
<u>top soil & clay</u>	<u>0</u>	<u>18</u>
<u>Red Chalk</u>	<u>18</u>	<u>35</u>
<u>sand</u>	<u>35</u>	<u>75</u>
<u>good gravel</u>	<u>75</u>	<u>85</u>


WELL LOCATION:
 sec. R 2 T. 3 N. ✓ R. 10 E. ✓
10 miles N of Tylertown
 (distance) (direction) (nearest town)

WELL PURPOSE: home
 (home, irrigation, municipal, industrial)

- WELL COMPLETION DATA:
- (1) diameter (inches) 4
 - (2) total depth (feet) 80
 - (3) static water level (feet) 50 below top of ground.
 - (4) casing plastic 74'
 (material) (depth)
4" if telescope see back.
 (size)
 - (5) screen 6' 74'
 (length) (depth to top)
4 plastic
 (size) (material)
 - (6) pump 1 Jet 10
 (HP) (yield gpm)
Elec
 (type power)
 - (7) electric log NO
 (yes or no)
 (organization running log)
 - (8) how well bottom plugged Wood Peg

CODED

DRILLERS REMARKS:

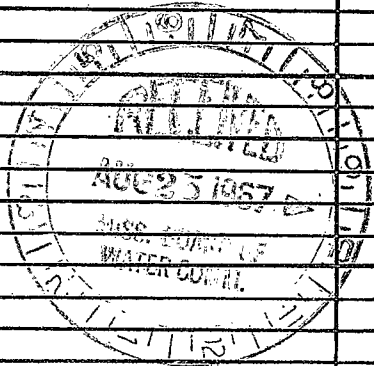

If well telescopes please sketch and show depths.

GROUND LEVEL

X			

SECTION 12

Please indicate well location X.

ADDITIONAL INFORMATION

If more than one screen, show locations of each on sketch.