

Walthall
C 21
9-67 CODED

MISSISSIPPI
BOARD OF WATER COMMISSIONERS
416 North State Street
Jackson, Mississippi 39201

WATER WELL DRILLERS LOG

9-20
date well completed

1967

Fitzgerald Well Service
firm name

Walthall
county well located

LANDOWNER: Napoleon Smith

description of formations encountered	from	to

Rt. 3, Tylertown Miss.
(mailing address)

red clay	0	20
Red sand	20	90
gravel	90	130
red clay	130	135
Coarse sand + gravel	135	143


WELL LOCATION:
sec. 2 T. 3 N. R. 9 E
1 1/2 miles E of Walthall
(distance) (direction) (nearest town)

WELL PURPOSE: Home
(home, irrigation, municipal, industrial)

WELL COMPLETION DATA:

- (1) diameter (inches) 4"
- (2) total depth (feet) 143'
- (3) static water level (feet) 120' below top of ground.
- (4) casing plastic, 137' (material) (depth)
4" (size) if telescope see back.
- (5) screen 6', 137' (length) (depth to top)
4" (size) Plastic (material)
- (6) pump ? (HP) ? (yield gpm)
- (7) electric log No (yes or no)
(organization running log)
- (8) how well bottom plugged Wood peg


CODED

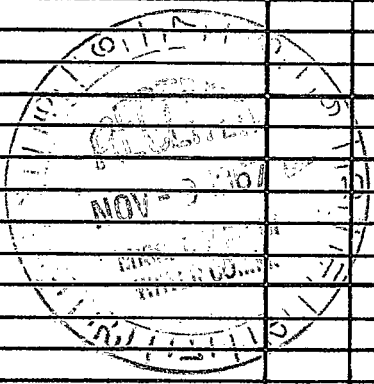

DRILLERS REMARKS:

If well telescopes please sketch and show depths.

GROUND LEVEL

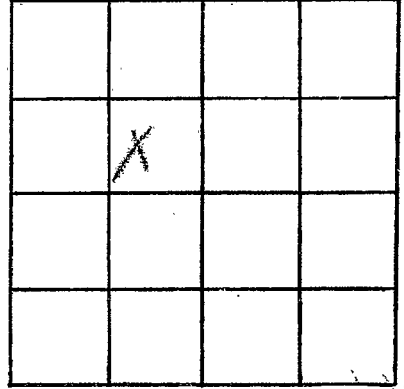

SECTION 2

Please indicate well location X.

ADDITIONAL INFORMATION

If more than one screen, show locations of each on sketch.