

Walthall
 C22
 9-67 CODED

MISSISSIPPI
 BOARD OF WATER COMMISSIONERS
 416 North State Street
 Jackson, Mississippi 39201

WATER WELL DRILLERS LOG

Sept 22 19 67 Flanagan Well Service Walthall
 date well completed firm name county well located

LANDOWNER: P. C. Thornton

description of formations encountered	depth	
	from	to
<u>Red clay</u>	0	20
<u>Red sand</u>	20	140
<u>Coarse sand & gravel</u>	140	155

pt 3, Tylertown Miss
 (mailing address)


WELL LOCATION:
 sec. 1 T 3 N R 8 E
S W
1.2 miles E of W Tomb
 (distance) (direction) (nearest town)

WELL PURPOSE: Home
 (home, irrigation, municipal, industrial)

WELL COMPLETION DATA:


- (1) diameter (inches) 4
- (2) total depth (feet) 155
- (3) static water level (feet) 95 below above top of ground.
- (4) casing Plastic 149
 (material) (depth)
4" if telescope see back.
 (size)
- (5) screen 6' 149
 (length) (depth to top)
4" Plastic
 (size) (material)
- (6) pump ? ?
 (HP) (yield gpm)
Clear
 (type power)
- (7) electric log No
 (yes or no)
 (organization running log)
- (8) how well bottom plugged wood peg

DRILLERS REMARKS:

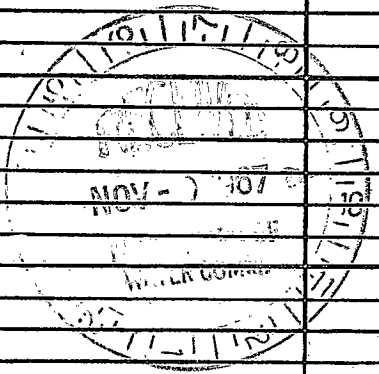

If well telescopes please sketch and show depths.

GROUND LEVEL

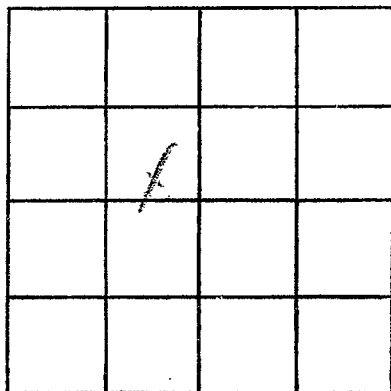

SECTION 1

Please indicate well location X.

ADDITIONAL INFORMATION

If more than one screen,
show locations of each on sketch.