

**MISSISSIPPI
BOARD OF WATER COMMISSIONERS
416 North State Street
Jackson, Mississippi 39201**

WATER WELL DRILLERS LOG

Walthall
C 23
9-67

CODED

9-21 1967 Fitzgerald well near Walthall
date well completed firm name county well located

LANDOWNER: Ollie Lee Sartin

description of formations encountered	from	to
<u>Red clay</u>	<u>0</u>	<u>20</u>
<u>Red soil</u>	<u>20</u>	<u>140</u>
<u>Coarse sand & gravel</u>	<u>140</u>	<u>157</u>

Rt. 3, Tylertown, Miss.
(mailing address)


WELL LOCATION:
sec. 1 T 3 N R 9 E
S W
1.2 miles E of M. Comb
(distance) (direction) (nearest town)

WELL PURPOSE: Home
(home, irrigation, municipal, industrial)

- WELL COMPLETION DATA:**
- (1) diameter (inches) 4
 - (2) total depth (feet) 157
 - (3) static water level (feet) 90 below above top of ground.
 - (4) casing Plastic, 151,
(material) (depth)
4" if telescope see back.
(size)
 - (5) screen 6', 151
(length) (depth to top)
4", Plastic
(size) (material)
 - (6) pump BUCKET P
(HP) (yield gpm)
Hand
(type power)
 - (7) electric log No
(yes or no)

(organization running log)
 - (8) how well bottom plugged wood peg


CODED

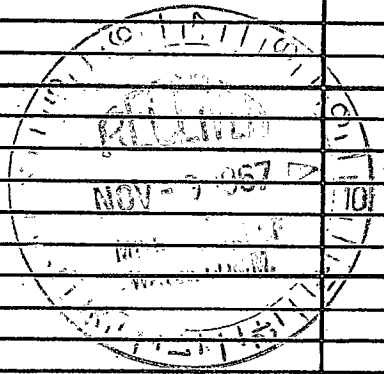

DRILLERS REMARKS: _____

If well telescopes please sketch and show depths.

GROUND LEVEL

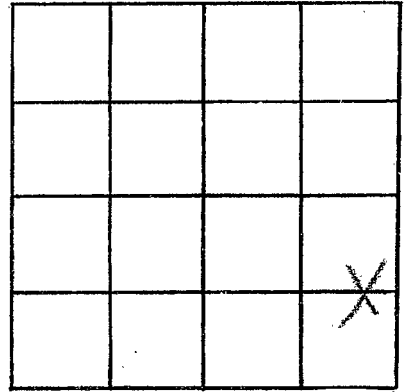

SECTION _____

Please indicate well location X.

ADDITIONAL INFORMATION

If more than one screen,
show locations of each on sketch.