

Walthall  
C 24  
10-67 CODED

MISSISSIPPI  
BOARD OF WATER COMMISSIONERS  
416 North State Street  
Jackson, Mississippi 39201

WATER WELL DRILLERS LOG

*Fitzgerald*  
firm name

*Walthall*  
county well located

19\_\_\_\_  
date well completed

LANDOWNER: *Jap Holmes*

*Rt 3 Tylertown Miss*

(mailing address)

WELL LOCATION:

sec *30* T *3* N *✓* R *9* E  
*10* miles *NW* of *Tylertown*  
(distance) (direction) (nearest town)

WELL PURPOSE:

(home, irrigation, municipal, industrial)

WELL COMPLETION DATA:


- (1) diameter (inches) *4*
- (2) total depth (feet) *122*
- (3) static water level (feet) *90* below/above top of ground.
- (4) casing *plastic, 1 1/2*  
(material) (depth)  
*4* if telescope see back.  
(size)
- (5) screen *6'*, *1 1/2*  
(length) (depth to top)  
*4*, *plastic*  
(size) (material)
- (6) pump \_\_\_\_\_  
(HP) (yield gpm)  
*Electric*  
(type power)
- (7) electric log *No*  
(yes or no)
- (organization running log) \_\_\_\_\_
- (8) how well bottom plugged *Wood peg*

description of formations encountered

from to

<i>Top Soil &amp; Clay</i>	<i>0</i>	<i>14</i>
<i>Red Chalk</i>	<i>14</i>	<i>36</i>
<i>Gravel - Heavy</i>	<i>36</i>	<i>94</i>
<i>Red sand</i>	<i>94</i>	<i>115</i>
<i>Coarse sand/gravel</i>	<i>115</i>	<i>122</i>
<i>Chalk white</i>		<i>122</i>


CODED

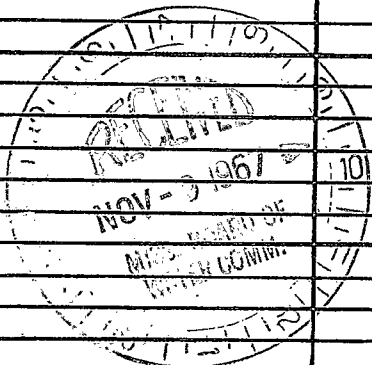

DRILLERS REMARKS:

If well telescopes please sketch and show depths.

GROUND LEVEL

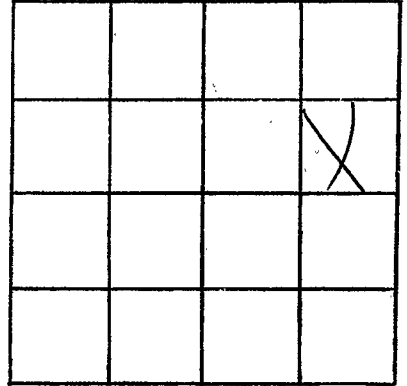

SECTION 30

Please indicate well location X.

ADDITIONAL INFORMATION

If more than one screen,  
show locations of each on sketch.