

Walthall
 C 25
 11-67
 CODED

MISSISSIPPI
 BOARD OF WATER COMMISSIONERS
 416 North State Street
 Jackson, Mississippi 39201

WATER WELL DRILLERS LOG

11-17 1969 date well completed
 69 Ferguson Water Well Sew Walthall firm name
 county well located

LANDOWNER: D. M. M...
 Tyler Town Rt Miss
 (mailing address)

description of formations encountered	from	to
top soil & clay	0	18
Red sand	18	60
Red Chalk	60	75
Fine Sand	75	90
Coarse Sand	90	120
Coarse Sand & gravel	120	130

WELL LOCATION:
 see 26 to N R 10 E S 5 W
 50 miles N of Tyler town
 (distance) (direction) (nearest town)

WELL PURPOSE: home
 (home, irrigation, municipal, industrial)

CODED

WELL COMPLETION DATA:

(1) diameter (inches) 4

(2) total depth (feet) 134

(3) static water level (feet) 90 below top of ground.

(4) casing plastic 138 (material) (depth)
 4 (size) if telescope see back.


(5) screen 6' 138 (length) (depth to top)
 4 plastic (size) (material)

(6) pump (HP) (yield gpm)
 5/2 (type power)

(7) electric log no (yes or no)
 (organization running log)

(8) how well bottom plugged Ward peg


CODED

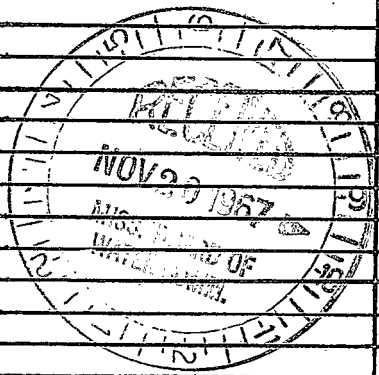

DRILLERS REMARKS:

If well telescopes please sketch and show depths.

GROUND LEVEL

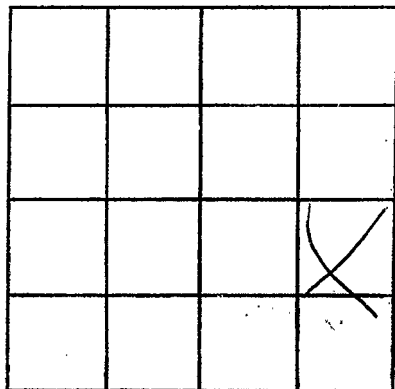

SECTION *026*

Please indicate well location X.

ADDITIONAL INFORMATION

If more than one screen,
show locations of each on sketch.