

Walthall
C 26
11-67 CODED

MISSISSIPPI
BOARD OF WATER COMMISSIONERS
416 North State Street
Jackson, Mississippi 39201

WATER WELL DRILLERS LOG

11-6-1967 date well completed
1967 Fitzgerald Water Well Sew Walthall firm name
county well located

LANDOWNER: Mallam Boyd
Tylertown Rt 3 Miss
(mailing address)

description of formations encountered	from	to
top soil & clay	0	25
Red Chalk	25	45
Red Sand	45	88
Sand & gravel	80	120


WELL LOCATION:
sec. 11 T. 3 N. R. 10 E
S W
10 miles N of Tylertown
(distance) (direction) (nearest town)

WELL PURPOSE: Home
(home, irrigation, municipal, industrial)

WELL COMPLETION DATA:

- (1) diameter (inches) 4
- (2) total depth (feet) 126
- (3) static water level (feet) 80 below above top of ground.
- (4) casing plastic, 120
(material) (depth)
- 4 If telescope see back.
(size)
- (5) screen 6', 120
(length) (depth to top)
- 4", plastic
(size) (material)
- (6) pump — —
(HP) (yield gpm)
- Elec
(type power)
- (7) electric log NO
(yes or no)
- (organization running log)
- (8) how well bottom plugged Wood peg


CODED

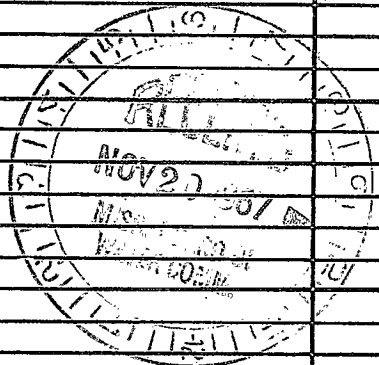

DRILLERS REMARKS:

If well telescopes please sketch and show depths.

GROUND LEVEL

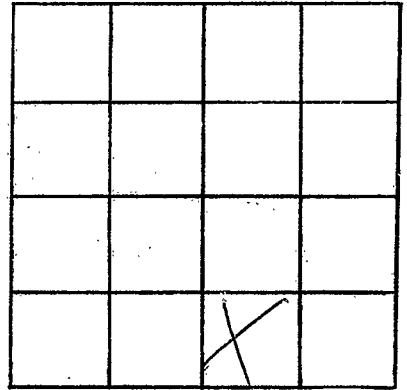

SECTION 11

Please indicate well location X.

ADDITIONAL INFORMATION

If more than one screen,
show locations of each on sketch.