

Walthall
C 27
2-68 CODED

MISSISSIPPI
BOARD OF WATER COMMISSIONERS
416 North State Street
Jackson, Mississippi 39201

WATER WELL DRILLERS LOG

Feb 14 1968 Fitzgerald well Inc Walthall
date well completed firm name county well located

LANDOWNER: Henry Carr
RR.

description of formations encountered from to

Tylutown, Miss.
(mailing address)

Red clay	0	20
Red sand	20	30
Coarse sand & gravel	30	100
White chalk	100	125
Blue chalk	125	155
Fine sand	155	160
Coarse sand	160	162

WELL LOCATION:

sec. 1 T 3 N R 9 E
3 miles SE of Prichard
(distance) (direction) (nearest town)

WELL PURPOSE: Home
(home, irrigation, municipal, industrial)

WELL COMPLETION DATA:

(1) diameter (inches) 4"
(2) total depth (feet) 180'
(3) static water level (feet) 95' below top of ground.

(4) casing Plastic 174' (material) (depth)
4" (size) if telescope see back.


(5) screen 6' (length) 174' (depth to top)
4" (size) Plastic (material)

(6) pump ? (HP) ? (yield gpm)
Elec (type power)

(7) electric log No (yes or no)
(organization running log)


(8) how well bottom plugged 2' of gravel

DRILLERS REMARKS:

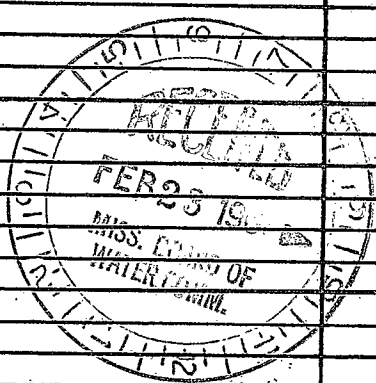

If well telescopes please
sketch and show depths.

GROUND LEVEL

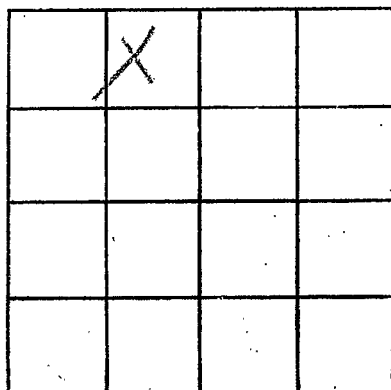

SECTION 1

Please indicate well location X.

ADDITIONAL INFORMATION

If more than one screen,
show locations of each on sketch.