

WALTHALL

C 29

6-25-71

MISSISSIPPI BOARD OF WATER COMMISSIONERS
416 North State Street
Jackson, Mississippi 39201

CODED

WATER WELL DRILLERS LOG

6-25 1971
date well completed

Fitzgerald Well Co
firm name

Walthall
county well located

LANDOWNER:

A. Slarum

description of formations encountered

from

to

RR Rte 1, Tylertown, Miss.
(mailing address)

Red clay 0 20
Red sand 20 30
Red gravel 35 120
Coarse silt & gravel 120 137

WELL LOCATION:

sec. 31 T. 30 N. R. 10 E
S
5 miles W of Tylertown
(distance) (direction) (nearest town)

WELL PURPOSE:

(home, irrigation, municipal, industrial)

WELL COMPLETION DATA:

- (1) diameter (inches) 4
- (2) total depth (feet) 137
- (3) static water level (feet) 124 below top of ground.
- (4) casing plastic, 129 (material) (depth)
4 (size) if telescope see back.
- (5) screen 8 (length), 129 (depth to top)
4 (size), plastic (material)
- (6) pump 1 (HP), 5 (yield gpm)
Elev (type power)
- (7) electric log (yes or no) no
(organization running log)
- (8) how well bottom plugged ahead

CODED


JUL 2

DRILLERS REMARKS:

MISS. DIV. OF WATER CONTROL

If well telescopes please sketch and show depths.

GROUND LEVEL

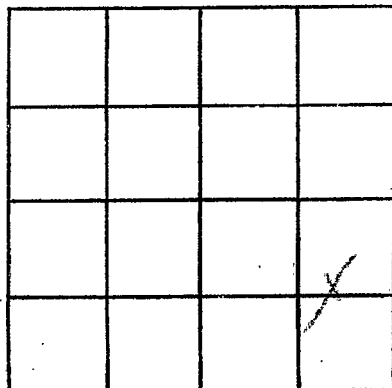

SECTION 31

Please indicate well location X.

ADDITIONAL INFORMATION

If more than one screen, show locations of each on sketch.