

WALTHAL

C 30

4-68

CODED

MISSISSIPPI BOARD OF WATER COMMISSIONERS 416 North State Street Jackson, Mississippi 39201

WATER WELL DRILLERS LOG

4-24

19

BB Fitzguald well serv

Walthall

date well completed

firm name

county well located

LANDOWNER:

Palmer Craft RR Lytleton, Miss

(mailing address)

WELL LOCATION:

sec 1 T 3 N R 9 E 5 miles SE of Prichard

WELL PURPOSE:

Home (home, irrigation, municipal, industrial)

WELL COMPLETION DATA:

- (1) diameter (inches) 4"
(2) total depth (feet) 180'
(3) static water level (feet) 110 below top of ground.
(4) casing Plastic 174 (material) (depth) 4" (size) if telescope see back.
(5) screen 6' 174' (length) (depth to top) 4" (size) Plastic (material)
(6) pump ? (HP) ? (yield gpm) Elec (type power)
(7) electric log No (yes or no)
(8) how well bottom plugged about 1/2

description of formations encountered

from

to

Red clay 0 30
Red sand 30 70
Red gravel 70 80
Red sand 80 130
FINE white sand 130 170
Coarse sand & gravel 170 180

CODED


MAY 14 1968

MISS. REG. WATER ENGINEERS

DRILLERS REMARKS:

If well telescopes please sketch and show depths.

GROUND LEVEL

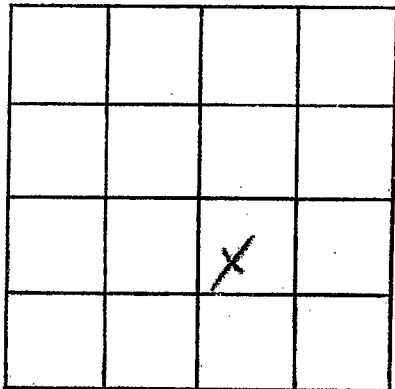

SECTION 1

Please indicate well location X.

ADDITIONAL INFORMATION

If more than one screen, show locations of each on sketch.