

Walthall
 C31
 5-12-67 **CODED**

MISSISSIPPI
 BOARD OF WATER COMMISSIONERS
 416 North State Street
 Jackson, Mississippi 39201

WATER WELL DRILLERS LOG

5-12-1967 Ferris + Elbert Brown Walthall
 date well completed firm name county well located

LANDOWNER:

H A Smith
Jaketown, Miss.
 (mailing address)

description of formations encountered

	from	to
Red clay	0	15
Sand + gravel	15	120
clay	120	145
Sand	145	160
Sand + gravel	160	175

WELL LOCATION:

sec. 36T 3N R 10E
5 miles north of Jaketown
 (distance) (direction) (nearest town)

WELL PURPOSE:

None
 (home, irrigation, municipal, industrial)

WELL COMPLETION DATA:

- (1) diameter (inches) 4 1/2"
- (2) total depth (feet) 174
- (3) static water level (feet) 120 below above top of ground.
- (4) casing Plastic, 169
 (material), (depth)

if telescope see back.
 (size)

- (5) screen 5', 169
 (length) (depth to top)

(size) (material)

- (6) pump 1, 6
 (HP) (yield gpm)


Elec
 (type power)

- (7) electric log No
 (yes or no)

(organization running log)

- (8) how well bottom plugged W V


CODED

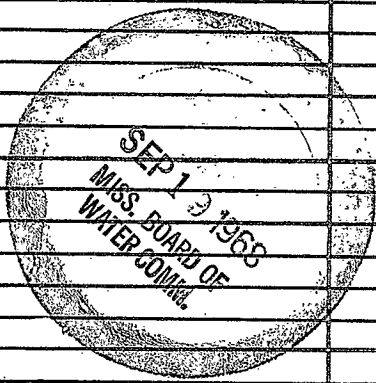

DRILLERS REMARKS:

If well telescopes please sketch and show depths.

GROUND LEVEL

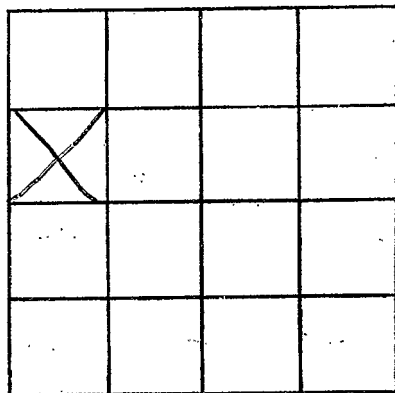

SECTION 36

Please indicate well location X.

ADDITIONAL INFORMATION

If more than one screen, show locations of each on sketch.