

Walthall
C32
7-11-67 CODED

MISSISSIPPI
BOARD OF WATER COMMISSIONERS
416 North State Street
Jackson, Mississippi 39201

WATER WELL DRILLERS LOG

July 11 1967 Ferniet Elbert Brown WALTHALL
date well completed firm name county well located

LANDOWNER:
CASS DILLON
ENON
(mailing address)

description of formations encountered	from	to
Red CLAY	0	25
Red CLAY & GRAVEL	25	70
SAND	70	115
SAND & GRAVEL	115	124

WELL LOCATION:
sec. 13 T 30 N R 9 E
6 miles S of ENON
(distance) (direction) (nearest town)

WELL PURPOSE: HOME
(home, irrigation, municipal, industrial)

WELL COMPLETION DATA:

(1) diameter (inches) 2"

(2) total depth (feet) 124'

(3) static water level (feet) 75' below top of ground.


(4) casing GALV. 124'
(material) (depth)
2" (size) if telescope see back.

(5) screen 5' 119'
(length) (depth to top)
2" STAINLESS STEEL
(size) (material)

(6) pump 3/4 H
(HP) (yield gpm)
ELECT
(type power)

(7) electric log _____
(yes or no)
(organization running log)


(8) how well bottom plugged W V

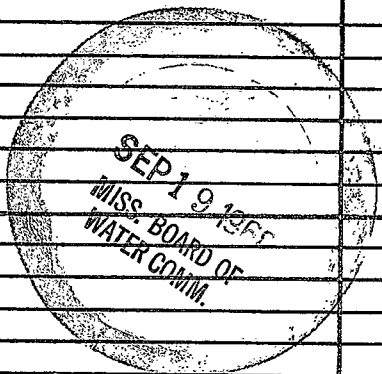

DRILLERS REMARKS: ROD TYPE PUMP

If well telescopes please sketch and show depths.

GROUND LEVEL

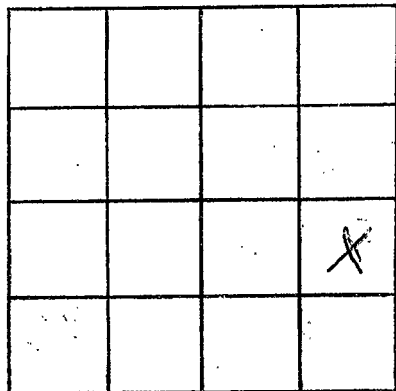

SECTION 13

Please indicate well location X.

ADDITIONAL INFORMATION

If more than one screen,
show locations of each on sketch.