

MISSISSIPPI
BOARD OF WATER COMMISSIONERS
416 North State Street
Jackson, Mississippi 39201

CODED

CODED

WATER WELL DRILLERS LOG

Walshall
C 35
1-30-69

1-30 1969 69 Fitzgerald Water Well Walshall
date well completed firm name county well located

LANDOWNER: Isiah Dillon

description of formations encountered

from to

Tylertown Rt 9 Miss

Red clay	0	20
Red sand	20	65
Red gravel	65	90
White chalk	90	150
Fine sand	150	170
Coarse sand & gravel	170	181

(mailing address)

WELL LOCATION:

sec. 13 T 3 N R 9 E
10 miles NE of Tylertown
(distance) (direction) (nearest town)

WELL PURPOSE: home
(home, irrigation, municipal, industrial)

WELL COMPLETION DATA:

- (1) diameter (inches) 4
- (2) total depth (feet) 181
- (3) static water level (feet) 125 below above top of ground.
- (4) casing plastic 175
(material) (depth)
4 if telescope see back.
(size)
- (5) screen 6 175
(length) (depth to top)
4 plastic
(size) (material)
- (6) pump 1/2 12
(HP) (yield gpm)
Electric
(type power)
- (7) electric log no
(yes or no)
(organization running log)
- (8) how well bottom plugged wooden

CODED


FEB 13 1969

MISS. BD. OF WATER COMMISSIONERS

DRILLERS REMARKS:

If well telescopes please sketch and show depths.

GROUND LEVEL

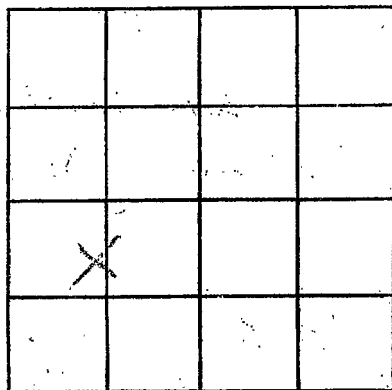

SECTION 13

Please indicate well location X.

ADDITIONAL INFORMATION

If more than one screen, show locations of each on sketch.