

WALTHALL

C 36

8-20-69

MISSISSIPPI BOARD OF WATER COMMISSIONERS 416 North State Street Jackson, Mississippi 39201

CODED

CODED

WATER WELL DRILLERS LOG

Aug 20 1969 Beechwell Pump Co - Walthall date well completed firm name county well located

LANDOWNER: Smith Bullock

Description of formations encountered

from to

PTD Tylerston - (mailing address)

Red clay	0	16
Red Sand/Clay	16	38
Red Sand - small gravel	38	83
gravel	83	94
Red chalky sand	94	113
Small pebbles and coarse sand	113	120

WELL LOCATION:

sec 29 T 3 N R 10 E 7 miles N-NW of Tylerston (distance) (direction) (nearest town)

WELL PURPOSE: Home (home, irrigation, municipal, industrial)

WELL COMPLETION DATA:

- (1) diameter (inches) 4"
- (2) total depth (feet) 120
- (3) static water level (feet) 87 below top of ground.
- (4) casing Plastic bottom (material) (depth)
- (size) if telescope see back.
- (5) screen 6' 114' (length) (depth to top) 4" Plastic (size) (material)
- (6) pump 1/2 sub 1/2 (HP) (yield gpm) 1/2 (type power)
- (7) electric log NO (yes or no)

(organization running log)

(8) how well bottom plugged wooden plug

DRILLERS REMARKS


old well not all fruit

SEP 29 1969

RD. 05

If well telescopes please sketch and show depths.

GROUND LEVEL

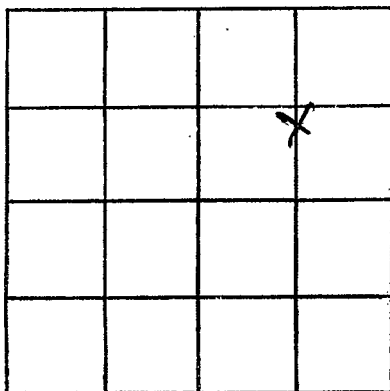

SECTION 29

Please indicate well location X.

ADDITIONAL INFORMATION

If more than one screen,
show locations of each on sketch.