

Walthall  
C 38  
9-11-69

MISSISSIPPI  
BOARD OF WATER COMMISSIONERS  
416 North State Street  
Jackson, Mississippi 39201

CODED  
CODED

WATER WELL DRILLERS LOG


9-11-69 date well completed  
Fitzgerald Well Serv firm name  
Walthall county well located

LANDOWNER:	description of formations encountered	from	to
James Halmis R.R. Tylertown Miss. (mailing address)	Red Clay	0	20
	Red Sand	20	50
	Red Sand & gravel	50	80
	Red clay	80	120
	Red Sand	120	158
	Coarse sand & gravel	158	164
WELL LOCATION: sec. 28 T-3 N R-10 E 6 miles NW of Tylertown (distance) (direction) (nearest town)			
WELL PURPOSE: Home (home, irrigation, municipal, industrial)			
WELL COMPLETION DATA: (1) diameter (inches) 4 (2) total depth (feet) 164 (3) static water level (feet) 120 below top of ground. (4) casing Plastic 158 (material) (depth) 4 (size) if telescope see back. (5) screen 6 158 (length) (depth to top) 4 plastic (size) (material) (6) pump 1/2 10 (HP) (yield gpm) 4 hp (type power) (7) electric log No (yes or no) (organization running log) (8) how well bottom plugged wood peg			
DRILLERS REMARKS:			

18 1969  
MISS. DEPT. OF WATER

If well telescopes please sketch and show depths.

GROUND LEVEL

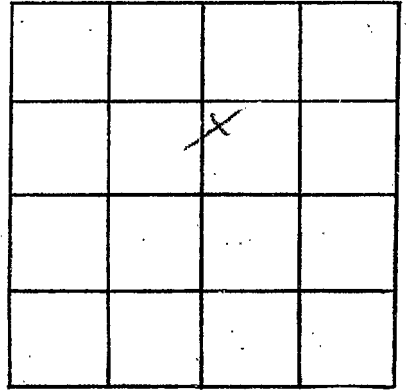

SECTION 28

Please indicate well location X.

ADDITIONAL INFORMATION

If more than one screen,  
show locations of each on sketch.