

MISSISSIPPI  
BOARD OF WATER COMMISSIONERS  
416 North State Street  
Jackson, Mississippi 39201

**CODED**

WATER WELL DRILLERS LOG

Walthall  
C 41  
3-26-70

3-26  
date well completed

1970 *Fitzmullin*  
firm name

*Walthall*  
county well located

LANDOWNER:

*George Holmes*

*R.R. Tylertown*  
(mailing address)

WELL LOCATION:

sec. 30 T. 3 N. R. 10 E.  
S  
3 miles W of Tylertown  
(distance) (direction) (nearest town)

WELL PURPOSE: Home  
(home, irrigation, municipal, industrial)

WELL COMPLETION DATA:

- (1) diameter (inches) 4
- (2) total depth (feet) 140
- (3) static water level (feet) 115 below top of ground.
- (4) casing Plexus 132  
(material) (depth)  
4 if telescope see back.  
(size)
- (5) screen 8 132  
(length) (depth to top)  
4 Plexus  
(size) (material)
- (6) pump 1/2 10  
(HP) (yield gpm)  
El  
(type power)
- (7) electric log no  
(yes or no)
- (8) how well bottom plugged woolly

description of formations encountered

from to

<i>Red clay</i>	0	15
<i>Red sand</i>	15	45
<i>Red chalk</i>	45	70
<i>White chalk</i>	70	100
<i>lime sand</i>	100	120
<i>blown sand</i>	120	140

**CODED**


APR - 6 1970

MISS. Bd. of WATER COMM.

DRILLERS REMARKS:

If well telescopes please sketch and show depths.

GROUND LEVEL

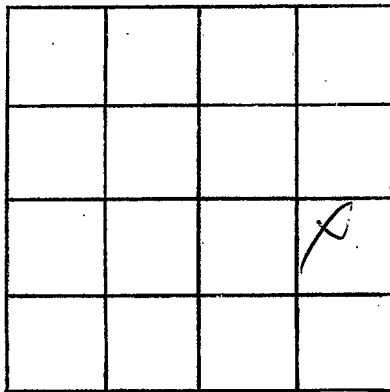

SECTION 30

Please indicate well location X.

ADDITIONAL INFORMATION

If more than one screen,  
show locations of each on sketch.