

Walthall
C 42
3-27-70

MISSISSIPPI
BOARD OF WATER COMMISSIONERS
416 North State Street
Jackson, Mississippi 39201

CODED

WATER WELL DRILLERS LOG

3-27 1970 *Fitzgerald Well Drilling* Walthall
date well completed firm name county well located

LANDOWNER:
Jack Jones
R.R. - Glendon, Miss.
(mailing address)

description of formations encountered	from	to
<i>Real chalk</i>	<i>0</i>	<i>30</i>
<i>white chalk</i>	<i>30</i>	<i>50</i>
<i>Real Chalk</i>	<i>50</i>	<i>75</i>
<i>white chalk</i>	<i>75</i>	<i>100</i>
<i>fine sand</i>	<i>100</i>	<i>120</i>
<i>coarse sand & gravel</i>	<i>120</i>	<i>140</i>

WELL LOCATION:
sec. *33* T. *3* (N) R. *10* (E)
6 miles *W* of *Glendon*
(distance) (direction) (nearest town)

WELL PURPOSE: ~~for water~~
(home, irrigation, municipal, industrial)

- WELL COMPLETION DATA:
- (1) diameter (inches) *4*
 - (2) total depth (feet) *140*
 - (3) static water level (feet) *100* below top of ground.
 - (4) casing *plaster*, *132*,
(material) (depth)
4 if telescope see back.
(size)
 - (5) screen *8*, *132*
(length) (depth to top)
4, *plaster*
(size) (material)
 - (6) pump *1/2*, *10*
(HP) (yield gpm)
elec
(type power)
 - (7) electric log *no*
(yes or no)
 - (organization running log)
 - (8) how well bottom plugged *well plug*

CODED


APR - 6 1970

MISS. Bd. of
WATER COMMISSIONERS

DRILLERS REMARKS:

If well telescopes please sketch and show depths.

GROUND LEVEL

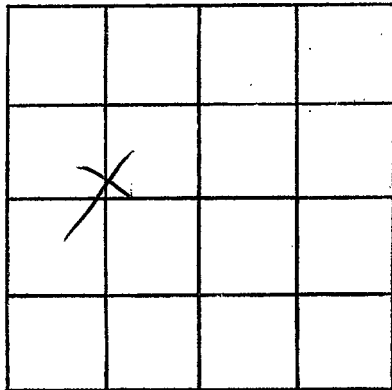

SECTION 33

Please indicate well location X.

ADDITIONAL INFORMATION

If more than one screen, show locations of each on sketch.