

Walthall
 C43
 3-30-70

MISSISSIPPI
 BOARD OF WATER COMMISSIONERS
 416 North State Street
 Jackson, Mississippi 39201

CODED

WATER WELL DRILLERS LOG

3-30 1970 Fitzgerald Walthall
 date well completed firm name county well located

LANDOWNER:
Alfred Holmes
R.R. Gleditsia, Miss
 (mailing address)

description of formations encountered	from	to
Red clay	0	15
Red chalk	15	24
fine sand	42	50
concrete gravel	50	100
fine white sand	100	125
gravel	125	142

WELL LOCATION:
 sec. 19 T. 3 S. R. 10 E.
10 miles WNW of Gleditsia
 (distance) (direction) (nearest town)

WELL PURPOSE: Home
 (home, irrigation, municipal, industrial)

- WELL COMPLETION DATA:
- (1) diameter (inches) 4
 - (2) total depth (feet) 142
 - (3) static water level (feet) 90 below top of ground.
 - (4) casing Plastic 134
 (material) (depth)
4 if telescope see back.
 (size)
 - (5) screen 8 134
 (length) (depth to top)
8 (size) Plastic (material)
 - (6) pump 1/2 8
 (HP) (yield gpm)
Ele (type power)
 - (7) electric log no
 (yes or no)
no (organization running log)
 - (8) how well bottom plugged Good

INDEX


APR - 6 1970

MISS. BD. OF
 WATER COMM.

DRILLERS REMARKS:

If well telescopes please sketch and show depths.

GROUND LEVEL

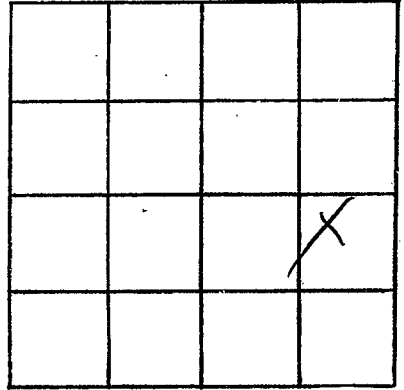

SECTION 19

Please indicate well location X.

ADDITIONAL INFORMATION

If more than one screen,
show locations of each on sketch.