

Walthall  
C 46  
6-17-70

MISSISSIPPI  
BOARD OF WATER COMMISSIONERS  
416 North State Street  
Jackson, Mississippi 39201

**CODED**

WATER WELL DRILLERS LOG

6-17 1970 *Fitzgerald Well Drilling* *Walthall*  
date well completed firm name county well located

LANDOWNER:  
*Scott Beier*  
*R.R. Lyburn, Jr.*  
(mailing address)

description of formations encountered	from	to
<i>Red Clay</i>	<i>2</i>	<i>20</i>
<i>Red sand</i>	<i>20</i>	<i>80</i>
<i>Red gravel</i>	<i>80</i>	<i>120</i>
<i>Coarse silt &amp; gravel</i>	<i>120</i>	<i>138</i>

WELL LOCATION:  
sec. *19* T. *3* N. R. *10* E  
*6* miles *N* of *Lyburn*  
(distance) (direction) (nearest town)

WELL PURPOSE: *drone*  
(home, irrigation, municipal, industrial)

- WELL COMPLETION DATA:
- (1) diameter (inches) *4*
  - (2) total depth (feet) *138*
  - (3) static water level (feet) *100* below top of ground.
  - (4) casing *Plaster*, *130*,  
(material) (depth)  
*4* If telescope see back.  
(size)
  - (5) screen *8*, *130*  
(length) (depth to top)  
*4*, *Plaster*  
(size) (material)
  - (6) pump *3/4*, *14*  
(HP) (yield gpm)  
*El*  
(type power)
  - (7) electric log *no*  
(yes or no)
  - (8) how well bottom plugged *sealed*

**CODED**


DRILLERS REMARKS:

JUN 29 1970

MISS. DIV. OF  
WATER CONTROL

If well telescopes please sketch and show depths.

GROUND LEVEL

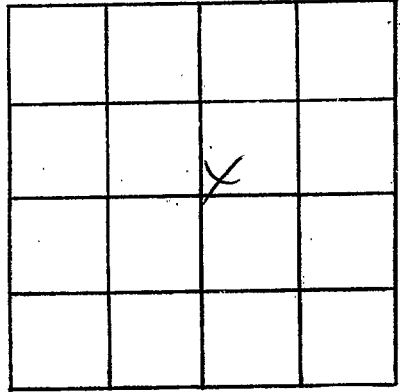

SECTION 19

Please indicate well location X.

ADDITIONAL INFORMATION

If more than one screen,  
show locations of each on sketch.