

WALTHALL

C 47

6-13-70

MISSISSIPPI BOARD OF WATER COMMISSIONERS
416 North State Street
Jackson, Mississippi 39201

CODED

WATER WELL DRILLERS LOG

June 13 1970 Chester Keems Walthall
date well completed firm name county well located

LANDOWNER: Mellon Owens

description of formations encountered from to

RFD - 181st Ave
(mailing address)

Clay 0 4
Chalk 4 30

WELL LOCATION:

sec 22 T 3 N R 100 E
7 miles W of Tylertown
(distance) (direction) (nearest town)

Sand & Stone 30 31
~~Sand & gravel~~ 31 50

WELL PURPOSE:

(home, irrigation, municipal, industrial)

Home

Sand & Red gravel 50 76
Clay 76 79

WELL COMPLETION DATA:

- (1) diameter (inches) 4"
- (2) total depth (feet) 123
- (3) static water level (feet) 90 below top of ground
- (4) casing Plastic Bottom
(material) (depth)

Red gravel & Sand 79 94
Sandstones 94 99
Sand 99 110
Red gravel & Sand 110 123

if telescope see back.
(size)

- (5) screen 6' 117
(length) (depth to top)
- 4" Plastic
(size) (material)

- (6) pump 1/2 HP 10
(HP) (yield gpm)
- Select
(type power)

- (7) electric log NO
(yes or no)

(organization running log)

- (8) how well bottom plugged wooden plug

DRILLERS REMARKS:
old Rod pump
Boke


CODED

OCT 14 1970

MISS. BD. OF WATER COMMISSIONERS

If well telescopes please sketch and show depths.

GROUND LEVEL

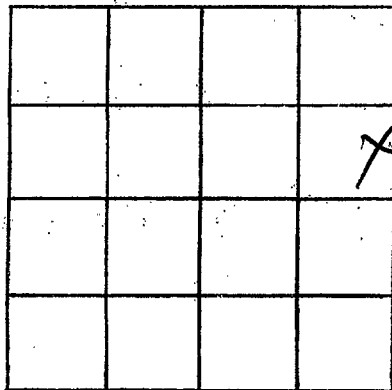

SECTION 22

Please indicate well location X.

ADDITIONAL INFORMATION

If more than one screen,
show locations of each on sketch.