

WALTHALL
 C 48
 9-11-70

MISSISSIPPI
 BOARD OF WATER COMMISSIONERS
 416 North State Street
 Jackson, Mississippi 39201

WATER WELL DRILLERS LOG

CODED

Sept 11 1970 J. T. Cringston Coon Walthall
 date well completed firm name county well located

LANDOWNER:
 Barnard Forrest
 Prindale Miss
 (mailing address)

description of formations encountered	from	to
Clay	0	40
Chalk	40	80
Gravel	80	100
Chalk	100	140
Sand + Gravel	140	164

WELL LOCATION:
 sec. 1 T. 3 N. R. 9 E.
 8 miles N/E of Smithfield
 (distance) (direction) (nearest town)

WELL PURPOSE: Home
 (home, irrigation, municipal, industrial)

- WELL COMPLETION DATA:
- (1) diameter (inches) 4"
 - (2) total depth (feet) 164
 - (3) static water level (feet) 140 below top of ground.
 - (4) casing (material) pl (depth) 158
 - (size) If telescope see back.
 - (5) screen (length) 158 (depth to top)
 - (size) 4" (material) pl
 - (6) pump (HP) 1/2 (yield gpm) 8
 - (type power) Elect.
 - (7) electric log (yes or no) No
 - (organization running log)
 - (8) how well bottom plugged wood

CODED


DEC 11 1970

DRILLERS REMARKS:

MISS. BD. OF
 WATER COM.

If well telescopes please sketch and show depths.

GROUND LEVEL

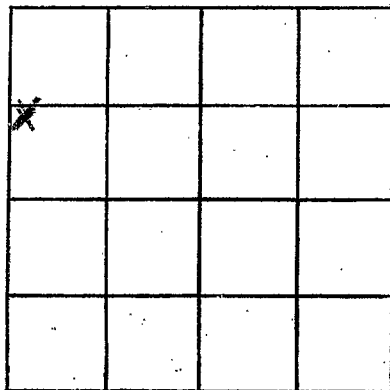

SECTION 1

Please indicate well location X.

ADDITIONAL INFORMATION

If more than one screen,
show locations of each on sketch.