

WALTHALL

C 49

12-1-70

MISSISSIPPI BOARD OF WATER COMMISSIONERS
416 North State Street
Jackson, Mississippi 39201

CODED

WATER WELL DRILLERS LOG

12-1
date well completed

70 *Fitzgibbon well dr.*
firm name

Walthall
county well located

LANDOWNER:

Suzanne Patton

P.R. Tyler, Miss.
(mailing address)

description of formations encountered

from to

Red clay

0 25

Red sand

25 70

Red gravel

70 115

Coarse sand

115 131

WELL LOCATION:

sec. 6 T. 30 N. R. 10 E.

7 miles W of Tylertown
(distance) (direction) (nearest town)

WELL PURPOSE: Home
(home, irrigation, municipal, industrial)

WELL COMPLETION DATA:

- (1) diameter (inches) 4
- (2) total depth (feet) 131
- (3) static water level (feet) 112 above top of ground.
- (4) casing plastic 123
(material) (depth)
- 4 if telescope see back.
(size)
- (5) screen 8 123
(length) (depth to top)
- 4 plastic
(size) (material)
- (6) pump 1 6
(HP) (yield gpm)
- EL
(type power)
- (7) electric log no
(yes or no)
- (organization running log)
- (8) how well bottom plugged wood

CODED


DEC 17 1970

DRILLERS REMARKS:

MISS. DR. CE
UNIV. COMM.

If well telescopes please sketch and show depths.

GROUND LEVEL

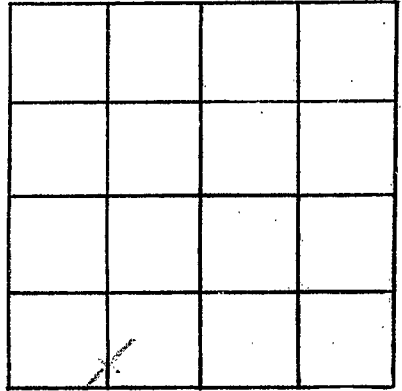

SECTION 6

Please indicate well location X.

ADDITIONAL INFORMATION

If more than one screen,
show locations of each on sketch.