

WALTHALL
C 50
12-3-70

MISSISSIPPI
BOARD OF WATER COMMISSIONERS
416 North State Street
Jackson, Mississippi 39201

CODED

WATER WELL DRILLERS LOG

12-3 date well completed 19 70 firm name *Fitzgerald Well Dr* county well located *Walthall*

LANDOWNER:
Willie Craft
R.D. Gledhill, Miss.
(mailing address)

description of formations encountered	from	to
<i>Red clay</i>	<i>0</i>	<i>20</i>
<i>Red sand</i>	<i>20</i>	<i>85</i>
<i>White Chalk</i>	<i>85</i>	<i>135</i>
<i>Thin sand</i>	<i>135</i>	<i>150</i>
<i>Coarse sand</i>	<i>150</i>	<i>160</i>

WELL LOCATION:
sec. *24* T. *3* N. R. *10E*
9 miles *N* of *Gledhill*
(distance) (direction) (nearest town)

WELL PURPOSE: *Home*
(home, irrigation, municipal, industrial)

- WELL COMPLETION DATA:
- (1) diameter (inches) *4*
 - (2) total depth (feet) *160*
 - (3) static water level (feet) *70* below top of ground.
 - (4) casing *plastic*, *152* (material) (depth)
4 if telescope see back. (size)
 - (5) screen *8*, *152* (length) (depth to top)
4, *plastic* (size) (material)
 - (6) pump *1*, *8* (HP) (yield gpm)
Elc. (type power)
 - (7) electric log *no* (yes or no)
(organization running log)
 - (8) how well bottom plugged *covered by*

CODED


DEC 17 1970

DRILLERS REMARKS:

MISS. ED. OF
WATER COMM.

If well telescopes please sketch and show depths.

GROUND LEVEL

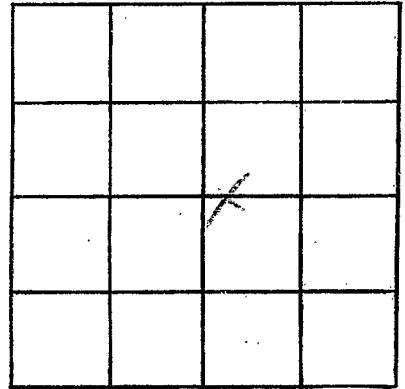

SECTION 24

Please indicate well location X.

ADDITIONAL INFORMATION

If more than one screen, show locations of each on sketch.