

WALTHALL  
C 51  
3-3-71

MISSISSIPPI  
BOARD OF WATER COMMISSIONERS  
416 North State Street  
Jackson, Mississippi 39201

**CODED**

WATER WELL DRILLERS LOG

3-3 1971 *Fitzgerald Well Dr* *Walthall*  
date well completed firm name county well located

LANDOWNER:  
*Need Leman*  
*R.R. Lyleston*  
(mailing address)

WELL LOCATION:  
sec. 7 T. 3 N. R. 10 E  
7 miles SE of Prichard  
(distance) (direction) (nearest town)

WELL PURPOSE:  
Home  
(home, irrigation, municipal, industrial)

- WELL COMPLETION DATA:
- (1) diameter (inches) 4
  - (2) total depth (feet) 143
  - (3) static water level (feet) 90 below above top of ground.
  - (4) casing Alu, 137,  
(material) (depth)  
4 If telescope see back.  
(size)
  - (5) screen 6, 137  
(length) (depth to top)  
4, Alu  
(size) (material)
  - (6) pump X, X  
(HP) (yield gpm)  
Hand  
(type power)
  - (7) electric log no  
(yes or no)  
(organization running log)
  - (8) how well bottom plugged newly

description of formations encountered	from	to
<i>Red Clay</i>	<i>0</i>	<i>20</i>
<i>Red gravel</i>	<i>20</i>	<i>90</i>
<i>Red Sand</i>	<i>90</i>	<i>130</i>
<i>Coarse sand &amp; gravel</i>	<i>130</i>	<i>143</i>

**CODED**


MAR 31 1971

DRILLERS REMARKS:

MISS. RD. OF  
WATER COMM.

If well telescopes please sketch and show depths.

GROUND LEVEL

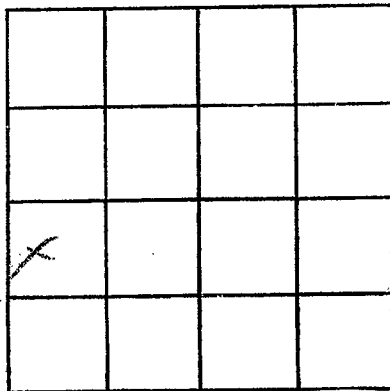

SECTION 7

Please indicate well location X.

ADDITIONAL INFORMATION

If more than one screen, show locations of each on sketch.