

WALTHALL
C-53
9-4-71

MISSISSIPPI
BOARD OF WATER COMMISSIONERS
416 North State Street
Jackson, Mississippi 39201

CODED

WATER WELL DRILLERS LOG

Sept. 4, 1971 Griner Drilling Co. Walthall
date well completed firm name county well located

LANDOWNER: Southeastern
Exp. Ltd. (1971) Seth E. Magee
Tylertown
(mailing address)

description of formations encountered	from	to
	<u>Top Soil</u>	<u>0</u>
<u>Clay</u>	<u>2</u>	<u>20</u>
<u>Sand and Gravel</u>	<u>20</u>	<u>294</u>

WELL LOCATION:
sec. 9 T. 30N R. 10E
810' S + 380' W of NE 1/4
(distance) miles (direction) of (nearest town)

WELL PURPOSE: oil field supply
(home, irrigation, municipal, industrial)

WELL COMPLETION DATA:

- (1) diameter (inches) 3
- (2) total depth (feet) 294
- (3) static water level (feet) 30 below above top of ground.
- (4) casing 8.1. 273'
(material) (depth)
3 if telescope see back.
(size)
- (5) screen 21, 273'
(length) (depth to top)
3, B.I. - Slotted
(size) (material)
- (6) pump Air Comp 60-70
(HP) (yield gpm)
Gas
(type power)
- (7) electric log No
(yes or no)
No
(organization running log)
- (8) how well bottom plugged Welded
Clear, Orange Beel.

CODED


SEP 23 1971

MISS. Bd. OF
WATER COMM.

DRILLERS REMARKS:

If well telescopes please sketch and show depths.

GROUND LEVEL

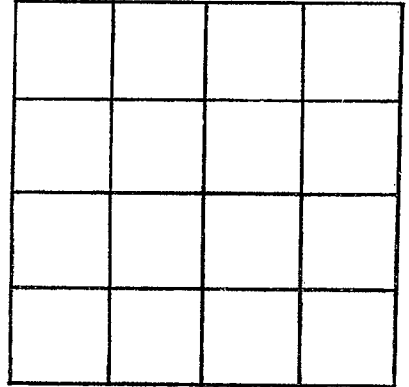

SECTION _____

Please indicate well location X.

ADDITIONAL INFORMATION

If more than one screen,
show locations of each on sketch.