

Walt Hall

C54

1-28-72

MISSISSIPPI BOARD OF WATER COMMISSIONERS 416 North State Street Jackson, Mississippi 39201

WATER WELL DRILLERS LOG

CODED

Jan 28 19 72 date well completed
F. G. Smith & Son firm name
Walthall county well located

Table with columns: LANDOWNER, WELL LOCATION, WELL PURPOSE, WELL COMPLETION DATA, description of formations encountered, from, to. Includes handwritten entries for owner (Turner Jones), location (6 miles N of Glendon), and completion data (4 inch diameter, 129 feet depth).


CODED

FEB 28 1972

DRILLERS REMARKS:

If well telescopes please sketch and show depths.

GROUND LEVEL

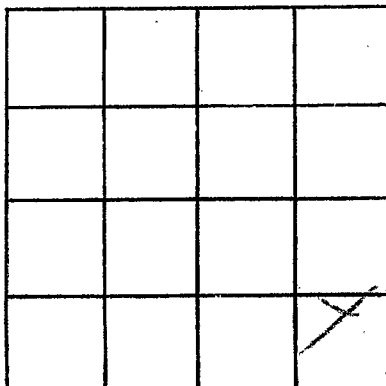

SECTION 30

Please indicate well location X.

ADDITIONAL INFORMATION

If more than one screen,  
show locations of each on sketch.