

WALTHALL
C56
2-14-72

MISSISSIPPI
BOARD OF WATER COMMISSIONERS
416 North State Street
Jackson, Mississippi 39201

CODED

WATER WELL DRILLERS LOG

Feb 14 1972 *Chester Keener* *Walthall*
date well completed firm name county well located

LANDOWNER: *Seth Magee*

description of formations encountered	from	to

#03
Walthall
(mailing address)

<i>red clay</i>	<i>0</i>	<i>25</i>
<i>red sand</i>	<i>25</i>	<i>42</i>
<i>Sand & gravel</i>	<i>42</i>	<i>58</i>
<i>Dark chalk sand</i>	<i>58</i>	<i>173</i>
<i>Coarse sand and small gravel</i>	<i>173</i>	<i>185</i>

WELL LOCATION:
sec *3* T *3* N R *10* E
9 miles *NW* of *Walthall*
(distance) (direction) (nearest town)

WELL PURPOSE: *Home*
(home, irrigation, municipal, industrial)

WELL COMPLETION DATA:

- (1) diameter (inches) *4"*
- (2) total depth (feet) *185*
- (3) static water level (feet) *70* below top of ground. *70* above
- (4) casing *cast* *bottom*
(material) (depth)
- (size) if telescope see back.
- (5) screen *6'* *179*
(length) (depth to top)
4" *cast*
(size) (material)
- (6) pump *ed pump*
(HP) (yield/gpm)
elect
(type power)
- (7) electric log *no*
(yes or no)

CODED

(organization running log)

(8) how well bottom plugged *wood plug*


DRILLERS REMARKS: *old well had*

JUN 29 1972

MISS. SD. CO.
WATER BOARD

If well telescopes please sketch and show depths.

GROUND LEVEL

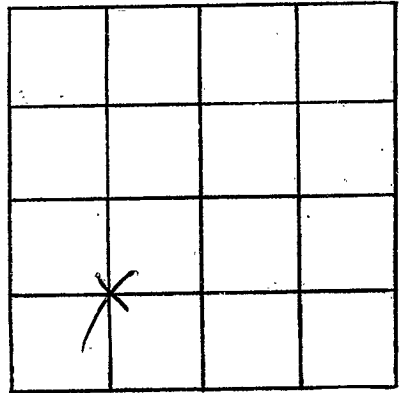

SECTION 3

Please indicate well location X.

ADDITIONAL INFORMATION

If more than one screen, show locations of each on sketch.