

WALTHALL  
 C 59  
 10-2-72

MISSISSIPPI  
 BOARD OF WATER COMMISSIONERS  
 416 North State Street  
 Jackson, Mississippi 39201

WATER WELL DRILLERS LOG

**CODED**

10-2-72 date well completed 1972 *F. J. Gumbel & Son* firm name *Walthall* county well located

LANDOWNER: *Leo G. Gumbel*  
*R.R. Gumbel & Son*  
 (mailing address)

description of formations encountered	from	to
<i>Red clay</i>	<i>0</i>	<i>20</i>
<i>Red sand</i>	<i>20</i>	<i>65</i>
<i>Red gravel</i>	<i>65</i>	<i>95</i>
<i>Red sand</i>	<i>95</i>	<i>120</i>
<i>Coarse sand &amp; gravel</i>	<i>120</i>	<i>131</i>

WELL LOCATION:  
 sec. *29* T. *3* N R. *10* E  
*8* miles *N* of *Tipton*  
 (distance) (direction) (nearest town)

WELL PURPOSE: *Home*  
 (home, irrigation, municipal, industrial)

- WELL COMPLETION DATA:
- (1) diameter (inches) *4*
  - (2) total depth (feet) *131*
  - (3) static water level (feet) *90* below above top of ground.
  - (4) casing *plastic*, *123*,  
 (material) (depth)  
*4* if telescope see back.  
 (size)
  - (5) screen *8*, *123*  
 (length) (depth to top)  
*4*, *plastic*  
 (size) (material)
  - (6) pump *1/2*, *10*  
 (HP) (yield gpm)  
*elec*  
 (type power)
  - (7) electric log *no*  
 (yes or no)  
 (organization running log)
  - (8) how well bottom plugged *hand plug*

**CODED**


DEC 17 1972

DRILLERS REMARKS:

PRINTED ON RECYCLED PAPER

If well telescopes please sketch and show depths.

GROUND LEVEL

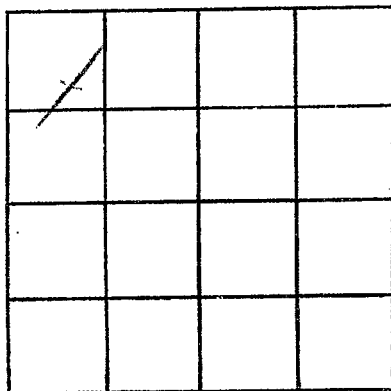

SECTION 29

Please indicate well location X.

ADDITIONAL INFORMATION

If more than one screen, show locations of each on sketch.